

Tallahatchie
 P 2002
 5/23/80

MISSISSIPPI
 BOARD OF WATER COMMISSIONERS
 416 North State Street
 Jackson, Mississippi 39201

WATER WELL DRILLERS LOG

4-23-80
 date well completed

RITANE GAS COMPANY
 OF GREENWOOD


Tallahatchie
 county well located

LANDOWNER:	description of formations encountered	from	to
Ralph Hand			
Glendora (mailing address)	Clay SAND SAND & GRAVEL	0 15 60	15 60 96
WELL LOCATION:			
sec. 33 T 23 N R. L 8 ?			
3/4 miles SW of GLENDORA			
(distance) (direction) (nearest town)			
WELL PURPOSE: Home (home, irrigation, municipal, industrial)			
WELL COMPLETION DATA:			
(1) diameter (inches) 4"			
(2) total depth (feet) 96			
(3) static water level (feet) 18 below top of ground.			
(4) casing PVC 76 (material) (depth)			
4" If telescope see back. (size)			
(5) screen 20' 76 (length) (depth to top)			
4" PVC (size) (material)			
(6) pump 1/2 70 (HP) (yield gpm)			
Elec (type power)			
(7) electric log No (yes or no)			
(organization running log)			
(8) how well bottom plugged Back Pressure Valve			
DRILLERS REMARKS:			

DEPT. OF NATURAL RESOURCES
 BUREAU OF LAND & WATER RESOURCES
 MAY 19 1980
 RECEIVED

If well telescopes please sketch and show depths.

GROUND LEVEL

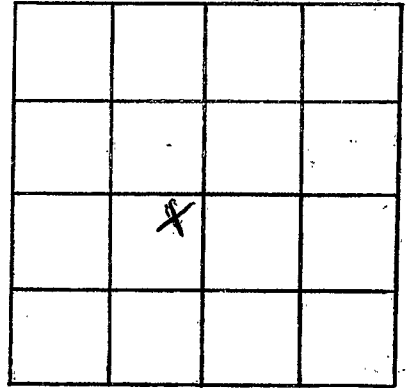

SECTION 33

Please indicate well location X.

ADDITIONAL INFORMATION

If more than one screen,
show locations of each on sketch.