

MISSISSIPPI DEPARTMENT OF NATURAL RESOURCES

Bureau of Land and Water Resources

Southport Mall

P.O. Box 10631

Jackson, Mississippi 39209

WATER WELL DRILLERS LOG

TALLAHATCHIE
 CL-2168 P2011
 7-2-82

7/2 19 82 LAYNE-CENTRAL CO. TALLAHATCHIE
 date well completed firm name county well located

LANDOWNER:	description of formations encountered	from	to
Hodges Farms			
Philipp, MS	sand	25	40
(mailing address)	sand & pea gravel	40	70
	gravel	70	105
	clay	105	
WELL LOCATION:			
sec. 36 T 23 N R 8 E			
5 miles NE of Philipp (distance) (direction) (nearest town)			
WELL PURPOSE: irrigation (home, irrigation, municipal, industrial)			
WELL COMPLETION DATA:			
(1) diameter (inches) 32"			
(2) total depth (feet) 105'			
(3) static water level (feet) 19' below top of ground.			
steel 55'			
(4) casing (material) (depth) 16" (size) if telescope see back. 50' 66'			
(5) screen (length) (depth to top) 16" st. steel (size) (material)			
(6) pump 60 (HP) 2500 (yield gpm) gear drive (type power)			
(7) electric log no (yes or no) (organization running log)			
(8) how well bottom plugged st. plate			
DRILLERS REMARKS:			


DEPT. OF NATURAL RESOURCES
 BUREAU OF LAND & WATER RESOURCES

SEP - 9 1982

RECEIVED

If well telescopes please sketch and show depths.

GROUND LEVEL

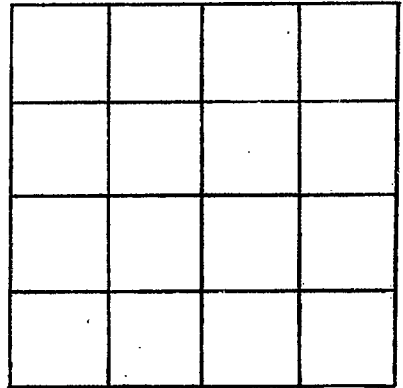

SECTION _____

Please indicate well location X.

ADDITIONAL INFORMATION

If more than one screen, show locations of each on sketch.