

CL-2115  
 P2012  
 MS-GW-05116

MISSISSIPPI  
 BOARD OF WATER COMMISSIONERS  
 416 North State Street  
 Jackson, Mississippi 39201  
 WATER WELL DRILLERS LOG

3-27 1982 LAYNE CENTRAL CO. TALLAHATCHIE  
 date well completed firm name county well located

LANDOWNER:  
 GREENWOOD IRRIGATION  
 @ RABBIT RIDGE PLANTATION  
 TIPPO, MS  
 (Crowe Farms)  
 (mailing address)

description of fomations encountered	from	to
clay	0	7
brown sand.	7	37
med. coarse sand	37	51
coarse sand	51	78
c. sand & gravel	78	110

WELL LOCATION: #3 of 7  
 sec. 6 T. 23 N R. 1 E  
 miles of Rabbit Ridge  
 (distance) (direction) (nearest town)

WELL PURPOSE:  
 (home, irrigation, municipal, industrial)

WELL COMPLETION DATA:

(1) diameter (inches) 32"

(2) total depth (feet) 110'

(3) static water level (feet) 12' below above top of ground.

(4) casing steel 60'  
 (material) (depth)  
 16" if telescope see back.  
 (size)

(5) screen 50' 60'  
 (length) (depth to top)  
 16" st. steel  
 (size) (material)

(6) pump 150 1900  
 (HP) (yield gpm)  
 gear drive  
 (type power)

(7) electric log no  
 (yes or no)

(organization running log) st. plate


(8) how well bottom plugged

DRILLERS REMARKS:

DEPT. OF NATURAL RESOURCES  
 BUREAU OF LAND & WATER RESOURCES  
 JUN 24 1982  
 RECEIVED

If well telescopes please sketch and show depths.

GROUND LEVEL

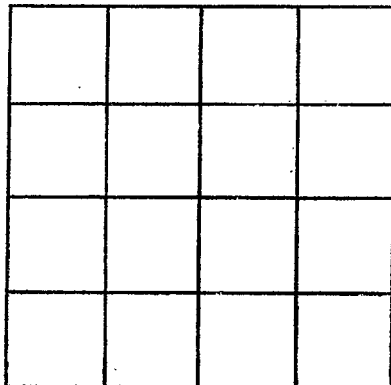

SECTION \_\_\_\_\_

Please indicate well location X.

ADDITIONAL INFORMATION

A series of 20 horizontal lines provided for entering additional information.

If more than one screen, show locations of each on sketch.