

CL-2115
 P 2013

MISSISSIPPI
 BOARD OF WATER COMMISSIONERS
 416 North State Street
 Jackson, Mississippi 39201
 WATER WELL DRILLERS LOG

3-29 1982 LAYNE-CENTRAL CO. TALLAHATCHIE
 date well completed firm name county well located


LANDOWNER:	description of formations encountered	from	to
GREENWOOD IRRIGATION	clay	0	10
@ RABBIT RIDGE PLANTATION	coarse brown sand	10	25
TIPPO, MS	fine sand	25	43
(mailing address) <i>(Crowe Farm)</i>	med. coarse sand	43	59
WELL LOCATION: # 4 of 7	coarse sand	59	67
6 23 sec. T N R 1 E	c. sand & pea gravel	67	98
Rabbit Ridge	c. sand & gravel	98	105
miles of (distance) (direction) (nearest town)	fine sand	105	108
WELL PURPOSE:			
(home, irrigation, municipal, industrial)			
WELL COMPLETION DATA:			
(1) diameter (inches) 32"			
(2) total depth (feet) 105'			
(3) static water level (feet) 11' below top of ground			
(4) casing steel 63' (material) (depth) 16" (size) if telescope see back.			
(5) screen 42' 63' (length) (depth to top) 16" (size) st. steel (material)			
(6) pump 150 (HP) 1800 (yield gpm) gear drive (type power)			
(7) electric log no (yes or no)			
(organization running log)			
(8) how well bottom plugged st. plate			

DRILLERS REMARKS:

DEPT. OF NATURAL RESOURCES
 BUREAU OF LAND & WATER RESOURCES
 JUN 24 1982
 RECEIVED

If well telescopes please sketch and show depths.

GROUND LEVEL

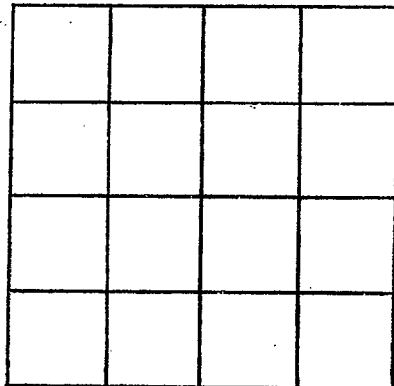

SECTION _____

Please indicate well location X.

ADDITIONAL INFORMATION

If more than one screen,
show locations of each on sketch.