

CL-2115
 P 2014

MISSISSIPPI
 BOARD OF WATER COMMISSIONERS
 416 North State Street
 Jackson, Mississippi 39201

WATER WELL DRILLERS LOG

4-3

82 LAYNE CENTRAL CO.

TALLAHATCHIE

date well completed

firm name

county well located

LANDOWNER:
 GREENWOOD IRRIGATION
 @ RABBIT RIDGE PLANTATION
 TIPPO, MS

(Craws Farms)
 (mailing address)

WELL LOCATION: #6 of 7
 sec. 5 T. 23 N R. 1 E

miles Rabbit Ridge
 (distance) (direction) (nearest town)

WELL PURPOSE:
 (home, irrigation, municipal, industrial)

WELL COMPLETION DATA:

- (1) diameter (inches) 32"
- (2) total depth (feet) 107'
- (3) static water level (feet) 12' below above top of ground.
- (4) casing steel 57'
 (material) (depth)
 16" if telescope see back.
 (size)
- (5) screen 50' 57'
 (length) (depth to top)
 16" st. steel
 (size) (material)
- (6) pump 40 650
 (HP) (yield gpm)
 gear drive
 (type power)
- (7) electric log no
 (yes or no)

(organization running log)

st. plate.

(8) how well bottom plugged

| description of fomations encountered | from | to |
|--------------------------------------|------|-----|
| clay | 0 | 11 |
| brown sand | 11 | 28 |
| med. coarse sand | 28 | 55 |
| c. sand | 55 | 79 |
| c. sand & pea gravel | 79 | 84 |
| c. sand & gravel | 84 | 108 |
| clay | 108 | |

DEPT. OF NATURAL RESOURCES
 BUREAU OF LAND & WATER RESOURCES


JUN 24 1982

RECEIVED

DRILLERS REMARKS:

If well telescopes please sketch and show depths.

GROUND LEVEL

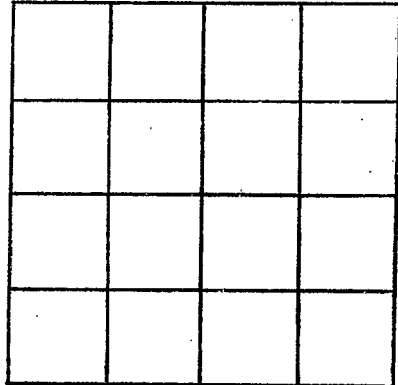

SECTION _____

Please indicate well location X.

ADDITIONAL INFORMATION

If more than one screen, show locations of each on sketch.