

CL-2115
 P 2015

MISSISSIPPI
 BOARD OF WATER COMMISSIONERS
 416 North State Street
 Jackson, Mississippi 39201

WATER WELL DRILLERS LOG

4-5 19 82 LAYNE CENTRAL CO. TALLAHATCHIE
 date well completed firm name county well located

LANDOWNER:
 GREENWOOD IRRIGATION
 @ RABBIT RIDGE PLANTATION
 TIPPO, MS
 (Crowe Farm)
 (mailing address)

description of formations encountered	from	to
clay	0	8
brown sand	8	27
med. coarse sand	27	57
coarse sand	57	71
c. sand & pea gravel	71	98
c. sand & gravel	98	104

WELL LOCATION: # 5 of 7
 sec. 5 T 23 N R 1 E
 Rabbit Ridge
 (distance) miles (direction) of (nearest town)


WELL PURPOSE:
 (home, irrigation, municipal, industrial)

- WELL COMPLETION DATA:
- (1) diameter (inches) 32"
 - (2) total depth (feet) 104'
 - (3) static water level (feet) 13' below top of ground.
 - (4) casing steel, 54' (material), (depth)
 16" (size) if telescope see back.
 - (5) screen 50' length, 54' (depth to top)
 16" (size), st. steel (material)
 - (6) pump 200 (HP), 2100 (yield gpm)
 gear drive (type power)
 - (7) electric log no (yes or no)
 (organization running log)
 - (8) how well bottom plugged st. plate

DRILLERS REMARKS:

If well telescopes please sketch and show depths.

GROUND LEVEL

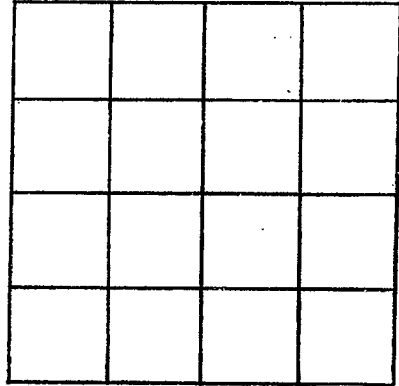

SECTION _____

Please indicate well location X.

ADDITIONAL INFORMATION

If more than one screen, show locations of each on sketch.