

CL-2115
 P 2016

MISSISSIPPI
 BOARD OF WATER COMMISSIONERS
 416 North State Street
 Jackson, Mississippi 39201

WATER WELL DRILLERS LOG

5-13

82

LAYNE CENTRAL CO.

TALLAHATCHIE

date well completed

firm name

county well located

LANDOWNER:	description of formations encountered	from	to
GREENWOOD IRRIGATION	clay	0	15
@ RABBIT RIDGE PLANTATION	fine sand	15	31
TIPPO, MS	med. coarse sand	31	38
(Crows Farm)	coarse sand	38	64
(mailing address)	C. SAND & pea gravel	64	76
WELL LOCATION: # 7 of 7	c. sand & gravel	76	102
sec. 5 T. 23 N. R. 1 E	clay	102	
Rabbit Ridge			
(distance) miles (direction) of (nearest town)			
WELL PURPOSE:			
(home, irrigation, municipal, industrial)			
WELL COMPLETION DATA:			
(1) diameter (inches) 32"			
(2) total depth (feet) 102'			
(3) static water level (feet) 13' below top of ground.			
(4) casing steel 52'			
(material) (depth)			
16" if telescope see back.			
(size) 50' 52'			
(5) screen (length) (depth to top)			
16" st. steel			
(size) (material)			
40 650			
(6) pump (HP) (yield gpm)			
gear drive			
(type power)			
no			
(7) electric log (yes or no)			
(organization running log)			
st. plate			
(8) how well bottom plugged			

DEPT. OF NATURAL RESOURCES
 BUREAU OF LAND & WATER RESOURCES


JUN 24 1982

RECEIVED

DRILLERS REMARKS:

If well telescopes please
sketch and show depths.

GROUND LEVEL

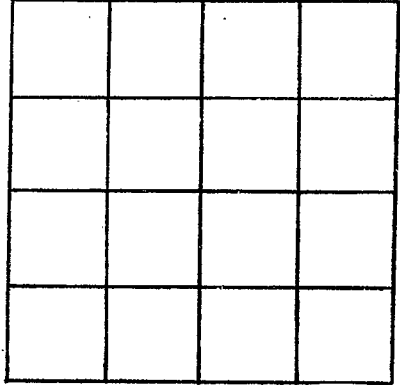

SECTION _____

Please indicate well location X.

ADDITIONAL INFORMATION

If more than one screen,
show locations of each on sketch.