

Tallahatchie  
 Q 13  
 12-68

MISSISSIPPI  
 BOARD OF WATER COMMISSIONERS  
 416 North State Street  
 Jackson, Mississippi 39201

CODED

WATER WELL DRILLERS LOG

1968 JAMES B. LIRE Tallahatchie  
 date well completed firm name county well located

LANDOWNER: Phelene Ch Raven

description of formations encountered	from	to
<u>Clay</u>	<u>0</u>	<u>20</u>
<u>Clay</u>	<u>20</u>	<u>40</u>
<u>Sand and clay</u>	<u>40</u>	<u>60</u>
<u>Sand and gravel</u>	<u>60</u>	<u>80</u>
<u>Gravel</u>	<u>80</u>	<u>100</u>
<u>Gravel</u>	<u>100</u>	<u>120</u>
<u>Sand and clay</u>	<u>120</u>	<u>140</u>
<u>Fine dry sand</u>	<u>140</u>	<u>160</u>
<u>Clay</u>	<u>160</u>	<u>180</u>
<u>Good sand</u>	<u>180</u>	<u>200</u>
<u>Good sand</u>	<u>200</u>	<u>233</u>

Cascilla  
Miss  
 (mailing address)

WELL LOCATION:  
 sec. 25 T. 23 N. R. 2 E.  
3 miles West of Cascilla  
 (distance) (direction) (nearest town)

WELL PURPOSE: home  
 (home, irrigation, municipal, industrial)

WELL COMPLETION DATA:


- (1) diameter (inches) 4"
- (2) total depth (feet) 233
- (3) static water level (feet) 120 below above top of ground.
- (4) casing Plastic, 2 1/8"  
 (material) (depth)  
 (size) if telescope see back.
- (5) screen 15" 2 1/8"  
 (length) (depth to top)  
4" Plastic  
 (size) (material)
- (6) pump 3/4 10  
 (HP) (yield gpm)  
Elec.  
 (type power)
- (7) electric log no  
 (yes or no)  
 (organization running log)
- (8) how well bottom plugged 4"  
Plastic plug

DRILLERS REMARKS:

Jan 9 1968  
 MISS. DEPT. OF  
 WATER RESOURCES

If well telescopes please sketch and show depths.

GROUND LEVEL

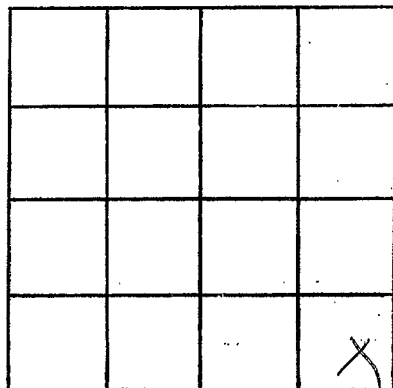

SECTION 25

Please indicate well location X.

ADDITIONAL INFORMATION

If more than one screen,  
show locations of each on sketch.