

TALAHATCHIE
 Q14
 5/74

MISSISSIPPI
 BOARD OF WATER COMMISSIONERS
 416 North State Street
 Jackson, Mississippi 39201

CODED

WATER WELL DRILLERS LOG

BUTANE GAS CO. OF GREENWOOD *Talahatchie*

date well completed 19 74 firm name BUTANE GAS CO. OF GREENWOOD county well located TALAHATCHIE

LANDOWNER: Boford Farms
Glendora, Miss.
 (mailing address)

description of formations encountered	from	to
<u>Clay</u>	<u>13'</u>	<u>15'</u>
<u>Sand</u>	<u>13'</u>	<u>40'</u>
<u>Sand & gravel</u>	<u>10'</u>	<u>7'</u>

WELL LOCATION:
 sec. 34 T 23 N R 2 E
 S W
5 miles sw of Glendora
 (distance) (direction) (nearest town)

Well # 1

WELL PURPOSE: FAR
 (home, irrigation, municipal, industrial)

WELL COMPLETION DATA:

(1) diameter (inches) 16"

(2) total depth (feet) 93

(3) static water level (feet) 10 below top of ground.

(4) casing Steel, 53
 (material) (depth)
16" if telescope see back.
 (size)

(5) screen 40, 53
 (length) (depth to top)
16" Steel
 (size) (material)

(6) pump 60 2000
 (HP) (yield gpm)
LP GAS
 (type power)

(7) electric log No
 (yes or no)

(organization running log)

(8) how well bottom plugged Steel Plate


CODED

DRILLERS REMARKS:

MAY 22 1974
 MISS. BOARD OF WATER COMMISSIONERS

If well telescopes please sketch and show depths.

GROUND LEVEL

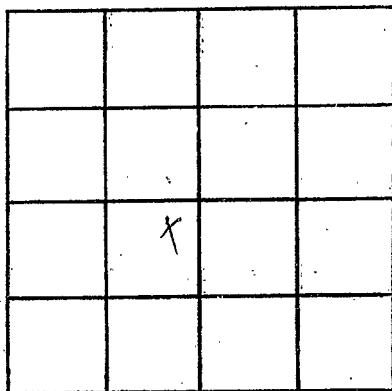

SECTION 34

Please indicate well location X.

ADDITIONAL INFORMATION

If more than one screen, show locations of each on sketch.