

Tallahatchie
 Q 17
 5-22-74

MISSISSIPPI
 BOARD OF WATER COMMISSIONERS
 416 North State Street
 Jackson, Mississippi 39201
CODED
 WATER WELL DRILLERS LOG

5/22/74 date well completed
 BUTANE GAS CO. OF GREENWOOD firm name
 Tallahatchie county well located

LANDOWNER:
 Buford Plantation
 Glendora, Miss.
 (mailing address)

description of formations encountered	from	to
CLAY	0	60
SAND & GRAVEL	60	93

WELL LOCATION:
 sec. 23 T. 23 N. R. 2 E
 S W
 1/2 miles NW of Glendora
 (distance) (direction) (nearest town)

Well #2

WELL PURPOSE: FRR.
 (home, irrigation, municipal, industrial)

WELL COMPLETION DATA:

(1) diameter (inches) 16"

(2) total depth (feet) 93

(3) static water level (feet) 12 below top of ground.

(4) casing Steel, 53 (material) (depth)
 16" (size) if telescope see back.

(5) screen 40' 53 (length) (depth to top)
 16" Steel (size) (material)

(6) pump 60 2000 (HP) (yield gpm)
 LP GAS (type power)

(7) electric log NO (yes or no)

(organization running log)

(8) how well bottom plugged
 Steel Plate

CODED


MAY 27 1974

MISS. B.L. Co.

DRILLERS' REMARKS:

If well telescopes please
sketch and show depths.

GROUND LEVEL

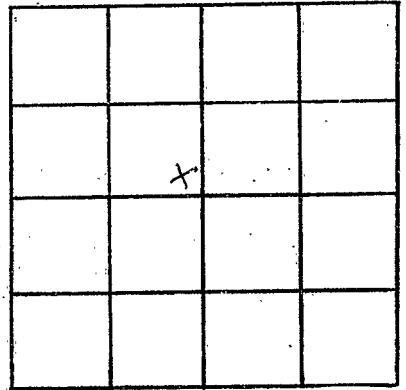

SECTION 23

Please indicate well location X.

ADDITIONAL INFORMATION

If more than one screen,
show locations of each on sketch.