

TAI HATCHIE
 Q18
 5-22-74

MISSISSIPPI
 BOARD OF WATER COMMISSIONERS
 416 North State Street
 Jackson, Mississippi 39201

CODED

WATER WELL DRILLERS LOG

BUIANE GAS CO. OF GREENWOOD

5/22/74
 date well completed

firm name

Tai Hatchie
 county well located

LANDOWNER:

Buford Plantation

Glenora Miss
 (mailing address)

description of formations encountered

from to

Clay	0	18
Sand	18	60
Sand & Gravel	60	97

WELL LOCATION:

sec. 24 T 23 N R 2 E
 3/2 miles NW of Glenora
 (distance) (direction) (nearest town)

WELL PURPOSE: Irr.
 (home, irrigation, municipal, industrial)

Well # 1

WELL COMPLETION DATA:

- diameter (inches) 16"
 - total depth (feet) 97
 - static water level (feet) 7 below top of ground.
 - casing Steel, 57' (depth)
 16" (size) if telescope see back.
 - screen 40' (length), 57' (depth to top)
 16" (size), Steel (material)
 - pump 60 (HP), 2000 (yield gpm)
 LPGAS (type power)
 - electric log No (yes or no)
- (organization running log)
- (8) how well bottom plugged: Steel Plate


CODED

DRILLERS REMARKS:

MAY 27 1974
 MISSISSIPPI BOARD OF WATER COMMISSIONERS

If well telescopes please sketch and show depths.

GROUND LEVEL

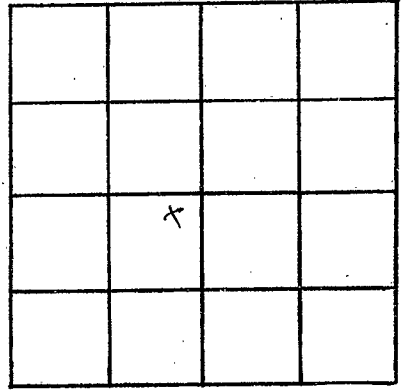

SECTION 24

Please indicate well location X.

ADDITIONAL INFORMATION

If more than one screen,
show locations of each on sketch.