

Tallahatchie

WATER WELL DRILLERS LOG

Date: 7/30, 1966, Driller: L. T. Cutts COUNTY Tallahatchie
 (Name)

(1) Owner of Land: Elzie Ballard
 (Name)
Rt. 2 Charleston, Miss
 (Address)
 (2) Location: NE 1/4, SE 1/4, Sec. 6 T22 R2E
4 miles West of Leveritt
 (distance) (direction) (Nearest Town)
 (3) Topography: level
 (Hilly) (Flat) (Level)
 (4) Purpose of Well: Domestic
 (Domestic Irrigation
 Municipal, Industrial, Other)

Description & Color of Materials Sand, Clay, Red Clay, Shell, etc.	Thick- ness Feet	Depth Feet
Dirt	21	21
blue sand	21	42
Coarse sand	31	73
gravel	45	118
Soapstone	50	168
Rocks (hard)	14"	169
Rocks (Soft)	2"	169
Shale + Soapstone	11	180
green sand	9	189
Brown sand	10	199
Soapstone	32	231
Soapstone & thin layers green sand	19	250
Rocks (hard)	4"	2
Soapstone	1	251
Rocks (hard)	6"	
Good water sand with thin layers of Soapstone + Shale	43	294
Soapstone	42	336
Soapstone + thin layers green sand	21	357
Greenish brown water sand.		
Screen set here	73	420
Soapstone	43	463

Information upon completion of well:


(1) Diameter 2 1/2 inches.
 (2) Total Depth 463 feet.
 (3) Water Level _____ feet below top of ground.
 (4) Cased to 26' of 2 1/2", Size 336' of 1 1/4"
 (5) Screen: Size Per 1 1/4", Length 42 ft.
 (6) Were any formations sealed against pollution?
 _____ yes, no.

336
129
462

If YES depth of formation _____

Why _____

Drillers Remarks: Will flow about
7 gal. per. min.

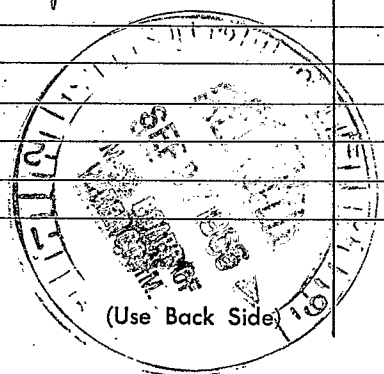

Well No. _____

Retain this copy for your office files.

