

TALLAHATCHIE
 Q 21
 12-17-76

MISSISSIPPI
 BOARD OF WATER COMMISSIONERS
 416 North State Street
 Jackson, Mississippi 39201

4

CODED

WATER WELL DRILLERS LOG

12-12-1976 date well completed
 Dyet Sullivan firm name
 TALLAHATCHIE county well located

LANDOWNER: STUTTGART, ECT.

STUTTGART, ARKANSAS

(mailing address)

WELL LOCATION:

sec. 33 T. 23 N R. 2 E
 14 miles S of CHARLESTON
 (distance) (direction) (nearest town)

WELL PURPOSE: Irr.
 (home, irrigation, municipal, industrial)

WELL COMPLETION DATA:

- (1) diameter (inches) 12ⁿ
- (2) total depth (feet) 69'
- (3) static water level (feet) 1' below top of ground.
- (4) casing Steel 29' (material), (depth)
 12ⁿ if telescope see back. (size)
- (5) screen 40' 29' (length), (depth to top)
 12ⁿ Steel (size), (material)
- (6) pump 40 1800 (HP), (yield gpm)
 Diesel (type power)
- (7) electric log NO (yes or no)
- (organization running log)
- (8) how well bottom plugged PIATE

description of formations encountered

from	to
0	9'
9	26'
26'	69'

CLAY
 SAND
 coarse SAND & GRAVEL
 CLAY


RECEIVED
 ALL INFORMATION
 JAN 11 1977

DRILLERS REMARKS:

MISS. BD. OF WATER COMMISSIONERS

If well telescopes please sketch and show depths.

GROUND LEVEL

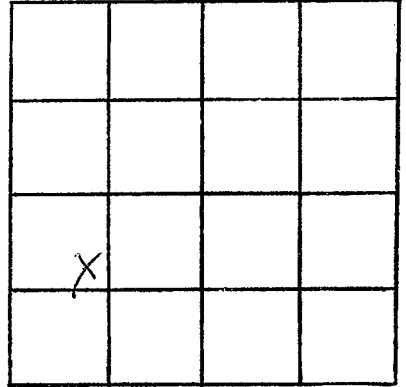

SECTION _____

Please indicate well location X.

ADDITIONAL INFORMATION

If more than one screen, show locations of each on sketch.