

MISSISSIPPI DEPARTMENT OF NATURAL RESOURCES

Bureau of Land and Water Resources

Southport Mall

P.O. Box 10631

Jackson, Mississippi 39209

WATER WELL DRILLERS LOG

CODED

Tallahatchie  
Q 23  
7/15/84

June 15 1984  
date well completed

Leeper Drilling  
firm name

Tallahatchie  
county well located

LANDOWNER: J.R. Wolfe  
FAYE Community  
Charleston Ms -  
(mailing address)

description of formations encountered	from	to
Top Clay	0	20
Fine Sand	20	30
Coarse Sand and Gravel	30	105

WELL LOCATION:  
sec. 5 T. 23 (N) R. 2 (E)  
3 miles S.W. of FAYE  
(distance) (direction) (nearest town)

WELL PURPOSE: irrigation  
(home, irrigation, municipal, industrial)

- WELL COMPLETION DATA:
- (1) diameter (inches) 10"
  - (2) total depth (feet) 105
  - (3) static water level (feet) 8 below top of ground.
  - (4) casing PVC, 65' (depth), 10" (size) if telescope see back.
  - (5) screen 40' (length), 65' (depth to top), 10" (size), PVC (material)
  - (6) pump 40 (HP), 1500 (yield gpm), Diesel (type power)
  - (7) electric log NO (yes or no)
  - (organization running log)
  - (8) how well bottom plugged CAP

CODED

DEPT. OF NATURAL RESOURCES  
BUREAU OF LAND & WATER RESOURCES


AUG 3 1984

RECEIVED

DRILLERS REMARKS:

If well telescopes please sketch and show depths.

GROUND LEVEL

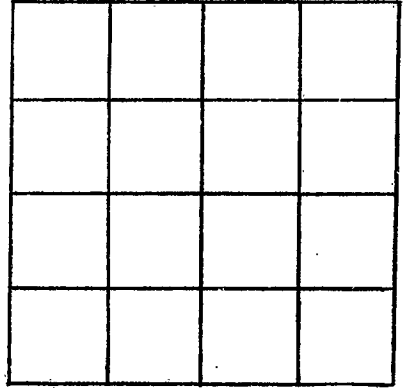

SECTION \_\_\_\_\_

Please indicate well location X.

ADDITIONAL INFORMATION

If more than one screen,  
show locations of each on sketch.