

MISSISSIPPI DEPARTMENT OF NATURAL RESOURCES

Bureau of Land and Water Resources

Southport Mall

P.O. Box 10631

Jackson, Mississippi 39209

WATER WELL DRILLERS LOG

CODED

TALLAHATCHIE
 CL-3150
 Q 24

10-5 19 85 LAYNE CENTRAL CO. TALLAHATCHIE
 date well completed firm name county well located

LANDOWNER:	description of formations encountered	from	to
COSSAR - BEAR LAKE HUNTING CLUB Charleston, MS (mailing address)	clay	0	19
	fine sand	19	35
	sand	35	75
	gravel	75	90

WELL LOCATION:
 sec. 32 T 23 N R. 2 E
 (distance) (direction) (nearest town)
6 miles NE of Philipp

WELL PURPOSE: irrig.
 (home, irrigation, municipal, industrial)

- WELL COMPLETION DATA:
- (1) diameter (inches) 7-7/8"
 - (2) total depth (feet) 90'
 - (3) static water level (feet) 27' below top of ground.
 - (4) casing pvc, 70'
 (material) (depth)
4" if telescope see back.
 (size)
 - (5) screen 20', 70'
 (length) (depth to top)
4", pvc
 (size) (material)
 - (6) pump 3 75
 (HP) (yield gpm)
elec.
 (type power)
 - (7) electric log no
 (yes or no)
 (organization running log)
 - (8) how well bottom plugged pvc cap

RECEIVED


NOV 14 1985

DRILLERS REMARKS:

Department of Natural Resources
 Bureau of Land & Water Resources

If well telescopes please sketch and show depths.

GROUND LEVEL

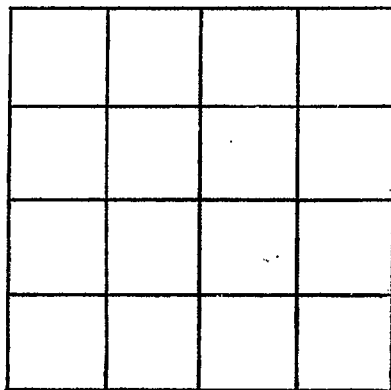

SECTION _____

Please indicate well location X.

ADDITIONAL INFORMATION

If more than one screen,
show locations of each on sketch.