

TALLAHATCHIE

Q 2001

4-17-78

MISSISSIPPI BOARD OF WATER COMMISSIONERS
416 North State Street
Jackson, Mississippi 39201

WATER WELL DRILLERS LOG
BUTANE GAS COMPANY

4-17-78 19
date well completed

OF GREENWOOD

Tallahatchie
county well located


LANDOWNER:	description of formations encountered	from	to
Elkendale Plantation SWAN LAKE (mailing address)	CLAY SAND SAND + GRAVEL	0 10 45	10 45 83
WELL LOCATION:			
sec. <u>2</u> T. <u>23</u> N R. <u>2</u> E S W <u>4</u> miles <u>N</u> of <u>Glendora</u> (distance) (direction) (nearest town)			
WELL PURPOSE: <u>Home</u> (home, irrigation, municipal, industrial)			
WELL COMPLETION DATA:			
(1) diameter (inches) <u>4"</u>			
(2) total depth (feet) <u>80</u>			
(3) static water level (feet) <u>18</u> below above top of ground.			
(4) casing <u>PVC</u> <u>60</u> (material) (depth) <u>4"</u> if telescope see back. (size)			
(5) screen <u>20</u> <u>60</u> (length) (depth to top) <u>4"</u> <u>PVC</u> (size) (material)			
(6) pump <u>1/2</u> <u>10</u> (HP) (yield gpm) <u>Elec</u> (type power)			
(7) electric log _____ (yes or no) _____ (organization running log)			
(8) how well bottom plugged <u>Back Pressure Valve</u>			
DRILLERS REMARKS:			

RECEIVED
APR 27 1978

MISS. BD. OF WATER COMM

If well telescopes please sketch and show depths.

GROUND LEVEL

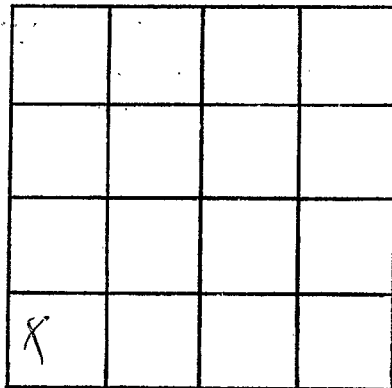

SECTION 2

Please indicate well location X.

ADDITIONAL INFORMATION

Lined area for additional information.

If more than one screen, show locations of each on sketch.