

TALLAHATCHIE

Q 2000

12-19-78

MISSISSIPPI BOARD OF WATER COMMISSIONERS  
416 North State Street  
Jackson, Mississippi 39201

WATER WELL DRILLERS LOG

12-19

1978 Lipe Well Co.

Tallahatchie

date well completed

firm name

county well located

LANDOWNER:

Russell Taylor

Cascilla MS.  
(mailing address)

WELL LOCATION:

sec. 23 T 28 N R 2 W  
7 miles south of Charleston  
(distance) (direction) (nearest town)

description of formations encountered

from to

TOP soil	0	20
sand	20	40
Gravel	40	80
Gravel and sand	80	100
Clay	100	140
Clay and sand	140	200
" " " "	200	250
sand	250	275

WELL PURPOSE:

(home, irrigation, municipal, industrial)

WELL COMPLETION DATA:

- (1) diameter (inches) 4
- (2) total depth (feet) 275
- (3) static water level (feet) 100 below top of ground.
- (4) casing PVC 265' (material) (depth)
- 4 (size) If telescope see back.
- (5) screen 10 265' (length) (depth to top)
- 4 PVC (size) (material)
- (6) pump 3/4 10 (HP) (yield gpm)
- elec. (type power)
- (7) electric log no (yes or no)
- no (organization running log)

(8) how well bottom plugged PVC Plug

DRILLERS REMARKS:


RECEIVED

JAN 10 1979

MISS. BOARD OF WATER COMMISSIONERS

If well telescopes please sketch and show depths.

GROUND LEVEL

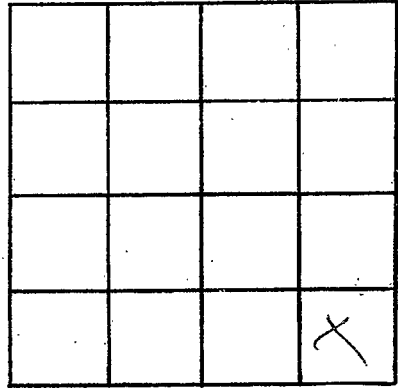

SECTION 23

Please indicate well location X.

ADDITIONAL INFORMATION

If more than one screen, show locations of each on sketch.