

Tallahatchie  
 Q 2004  
 12/81

MISSISSIPPI  
 BOARD OF WATER COMMISSIONERS  
 416 North State Street  
 Jackson, Mississippi 39201

WATER WELL DRILLERS LOG

Dec 19 81 date well completed Thomas firm name Tallahatchie county well located

LANDOWNER: William L. Cox  
Holcomb, MS.  
 (mailing address)

WELL LOCATION:  
 sec 23 T 2 N R 2 E  
13 miles S of Charleston  
 (distance) (direction) (nearest town)

WELL PURPOSE:  
 (home, irrigation, municipal, industrial)


- WELL COMPLETION DATA:
- (1) diameter (inches) 2
- (2) total depth (feet) 493
- (3) static water level (feet) 39 <sup>below</sup> above top of ground.
- (4) casing PVC, 463,  
 (material) (depth)  
2 If telescope see back.  
 (size)
- (5) screen 30, 463  
 (length) (depth to top)  
2", 10 slot PVC  
 (size) (material)
- (6) pump 20  
 (HP) (yield gpm)  
with over Air Comp.  
 (type power)  
we didn't install  
 (7) electric log (yes or no)  
A Pump  
 (organization running log)
- (8) how well bottom plugged

description of formations encountered	from	to
Grit and SAND	19	6
Soft Chalk and SAND	6	60
SAND	60	106
SHALE	106	128
Rock (mostly) and SHALE	128	136
Dirty Green SAND	136	157
Brown dirt	157	160
STKS Brown SAND	160	190
L Brown CHALK		
Rock and Green SAND	190	217
Black dirt	217	221
Green SAND	221	250
Black dirt	250	270
STK white SAND and CHALK	270	288
Green SAND	288	300
SHALE	300	388
STKS SAND and SHALE	388	428
Hard shale	428	456
Mostly SAND STKS	455	470
CHALK		
Real Porous SAND	470	493

DRILLERS REMARKS: 9 mi -  
No Holcomb

If well telescopes please sketch and show depths.

GROUND LEVEL

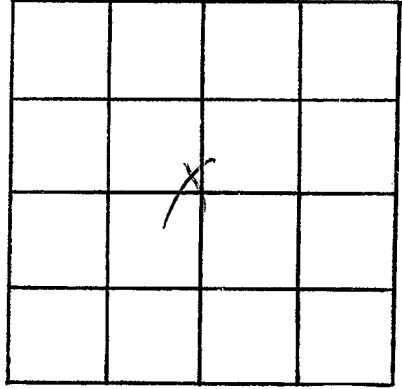

SECTION 23

Please indicate well location X.

ADDITIONAL INFORMATION

If more than one screen, show locations of each on sketch.