

MISSISSIPPI DEPARTMENT OF NATURAL RESOURCES

Bureau of Land and Water Resources

Southport Mall

P.O. Box 10631

Jackson, Mississippi 39209

WATER WELL DRILLERS LOG

BUTANE GAS COMPANY

OF GREENWOOD

Tallahatchie
county well located

TALLAHATCHIE
Q 2005

6-21-84
date well completed

1984

firm name

LANDOWNER:

Bob Harris

Holcomb Mo.
(mailing address)

description of formations encountered

from to

0	18
18	60
60	85
85	90

WELL LOCATION:

sec. 28 T. 23 N. R. 20 E.
S W
5 miles SW. of Coalinga
(distance) (direction) (nearest town)

WELL PURPOSE:

(home, irrigation, municipal, industrial)

WELL COMPLETION DATA:

- (1) diameter (inches) 4"
- (2) total depth (feet) 90'
- (3) static water level (feet) 11 below above top of ground.
- (4) casing PVC, 80' (material), (depth)
4" (size) if telescope see back.
- (5) screen 10', 80' (length), (depth to top)
4" PVC (size), (material)
- (6) pump 1/2 (HP), 8 (yield gpm)
Elec. (type power)
- (7) electric log No (yes or no)
No (organization running log)

(8) how well bottom plugged
Back with Valve

DRILLERS REMARKS:

Richard Vest


DEPT. OF NATURAL RESOURCES
BUREAU OF LAND & WATER RESOURCES

JUL 21 1984

RECEIVED

If well telescopes please sketch and show depths.

GROUND LEVEL

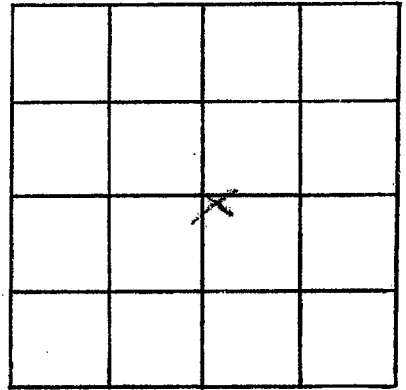

SECTION 28

Please indicate well location X.

ADDITIONAL INFORMATION

If more than one screen,
show locations of each on sketch.