

R-1

4-14-64

WATER WELL DRILLERS LOG

CODED

Date: 4-14- 1964, Driller: Layne-Central Co. County Tallahatchie

CODED

(Name)

(1) Owner of Land: Cascilla Water Assn.
(Name)

Cascilla, Mississippi
(Address)

(2) Location: 1/4, 1/4, Sec. 17 T23R3E

in town of Cascilla
miles of (Nearest Town)
(distance) (direction)

(3) Topography: _____
(Hilly) (Flat) (Level)

(4) Purpose of Well: municipal
(Domestic Irrigation
Municipal, Industrial, Other)

Information upon completion of well:

(1) Diameter 8 inches

(2) Total Depth 576' 6" feet.

(3) Water Level 194 feet below top of ground.

(4) Cased to 471', Size 8"

(5) Screen: Size 4", Length 40'

(6) Were any formations sealed against pollution?


yes, _____ no.

If YES depth of formation 471'

Why required

Drillers Remarks:

Description & Color of Materials Sand, Clay, Red Clay, Shell, etc.	Thick- ness Feet	Depth Feet
		0
silty clay	11	11
clay	17	28
pink clay	11	39
sand	14	53
sand-gravel	30	83
sand	12	95
sand stks.-clay	5	100
white clay	20	120
sand stks-clay	6	126
clay	124	250
shale stks thin rock	13	263
sandy shale	66	329
fine black sand	12	341
sandy shale	19	360
sand stks shale	40	400
sand	12	412
sand stks shale	48	460
shale	28	488
shale stks sand	46	534
sand	38	572
shale	4	576

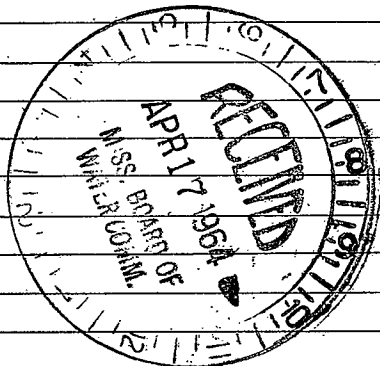

(Use Back Side)

Well No.

100

100

100

100