

CODED

Zallahalchie
R-2
9-69
U.S.G.S

MISSISSIPPI
BOARD OF WATER COMMISSIONERS E LOG # 36
416 North State Street
Jackson, Mississippi 39201

WATER WELL DRILLERS LOG

Zallahalchie
Grenada

Sept. 1969 T.M. PARKS DRILG Co. Grenada
date well completed firm name county well located


LANDOWNER: <u>Dea Ridge Water</u>	Description of formations encountered	from	to
<u>Grenada, County Miss,</u>	CLAYS + SANDS	0	90
(mailing address)	SAND	90	220
WELL LOCATION:	SANDY red w/ grey	220	400
sec. <u>12</u> T. <u>23</u> N R. <u>3</u> E	SAND	400	540
<u>8</u> mi miles <u>NW</u> of <u>Grenada</u>	sandy w/ clay etc	540	980
(distance) (direction) of (nearest town)	SAND GOOD	980	1000
WELL PURPOSE: <u>Municipal</u>	Black Lignite	1000	1009
(home, irrigation, municipal, industrial)	Good SAND	1009	1080
WELL COMPLETION DATA:	Lignite Black	1080	1104
(1) diameter (inches) <u>8 5/8</u>	Good SAND	1104	1140
(2) total depth (feet) <u>1209</u>	SAND w/ Black	1140	1200
(3) static water level (feet) <u>182</u> below above top of ground.	PURE BLACK	1200	1209
(4) casing <u>Steel</u> <u>980'</u>	T.D.		
(material) (depth)			
<u>4"</u> if telescope see back.			
(size)			
(5) screen <u>60'</u> <u>1010'</u>			
(length) (depth to top)			
<u>4"</u> <u>Stainless</u>			
(size) (material)			
(6) pump <u>20</u> <u>110</u>			
(HP) (yield gpm)			
<u>3 phase</u>			
(type power)			
(7) electric log <u>YES</u>			
(yes or no)			
<u>U.S. G.S.</u>			
(organization/running log)			
(8) how well bottom plugged <u>BPV</u>			
DRILLERS REMARKS: <u>GRAVEL</u>			
<u>WALL Well - 420 DAWs</u>			
<u>#20 slot screen</u>			

OCT 7 1969

MISS. BD. OF
WATER COMM

If well telescopes please sketch and show depths.

GROUND LEVEL

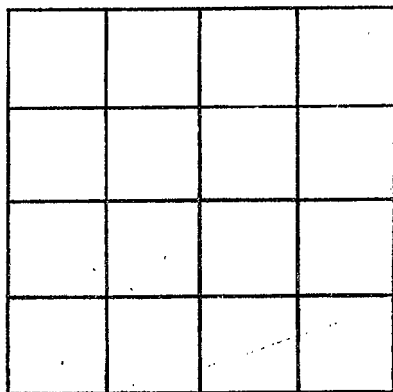

SECTION _____

Please indicate well location X.

ADDITIONAL INFORMATION

If more than one screen,
show locations of each on sketch.