

CODED

Tallahassee  
Panama

# WATER WELL DRILLERS LOG

TALLA.

R 4

Date: 3-12-62, 1962, Driller: Joe R. Lynn County Panama

3-12-62

(Name)

(1) Owner of Land: Robert S. Whites  
(Name)

Cassillia, Miss  
(Address)

(2) Location: 1/4, 1/4, Sec. 13 T. 23 R. 3  
N. E. / 1/4 1/4 1/4

4 miles S. east of Cassilla  
(distance) (direction) (Nearest Town)

(3) Topography: Hilly  
(Hilly) (Flat) (Level)

(4) Purpose of Well: Domestic  
(Domestic Irrigation, Municipal, Industrial, Other)

Description & Color of Materials  
Sand, Clay, Red Clay, Shell, etc.

Thick-  
ness  
Feet

Depth  
Feet

<u>Red clay</u>	<u>0</u>	<u>30</u>
<u>ground</u>	<u>30</u>	<u>40</u>
<u>Red clay &amp; sand</u>	<u>10</u>	<u>60</u>
<u>1/4</u> <u>1/4</u> <u>1/4</u>	<u>60</u>	<u>117</u>

### Information upon completion of well:

(1) Diameter 2 inches.

(2) Total Depth 117 feet.

(3) Water Level 40 feet below top of ground.

(4) Cased to 105, Size 2"

(5) Screen: Size 1/4, Length 6'


(6) Were any formations sealed against pollution?

\_\_\_\_\_ yes, \_\_\_\_\_ no.

If YES depth of formation \_\_\_\_\_

Why \_\_\_\_\_

Drillers Remarks: cut sand  
rock at 117', red  
sand under rock

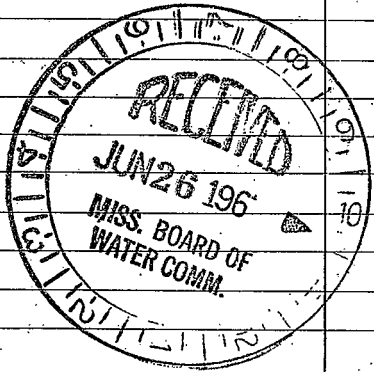

(Use Back Side)

Well No.

Retain this copy for your office files.

