

WATER WELL DRILLERS LOG

Jalalatchie

Date: *6-22*, 19*64*, Driller: *Frank Taylor* County: *Marble*
 (Name)

(1) Owner of Land: *B.L. Bukom*
 (Name)
Asubon, Miss
 (Address)

(2) Location: $\frac{1}{4}$, $\frac{1}{4}$, Sec. *9 T²³N R³E*
15 miles *West*, of *Scobey*
 (distance) (direction) (Nearest Town)

(3) Topography: *Hilly*
 (Hilly) (Flat) (Level)

(4) Purpose of Well: *Domestic*
 (Domestic Irrigation
 Municipal, Industrial, Other)

Description & Color of Materials Sand, Clay, Red Clay, Shell, etc.	Thick-ness Feet	Depth Feet
<i>Clay</i>	<i>0</i>	<i>45</i>
<i>gravel + sand</i>	<i>45</i>	<i>90</i>
<i>gravel</i>	<i>90</i>	<i>90</i>
<i>gravel</i>	<i>90</i>	<i>112</i>
<i>strata sand</i>	<i>112</i>	<i>130</i>

Information upon completion of well:

(1) Diameter *2* inches.

(2) Total Depth *130* feet.

(3) Water Level *80* feet below top of ground.

(4) Cased to *121*, Size *2*


(5) Screen: Size *1 1/4*, Length *6*

(6) Were any formations sealed against pollution?
 _____ yes, _____ no.

If YES depth of formation _____

Why _____

Drillers Remarks: _____

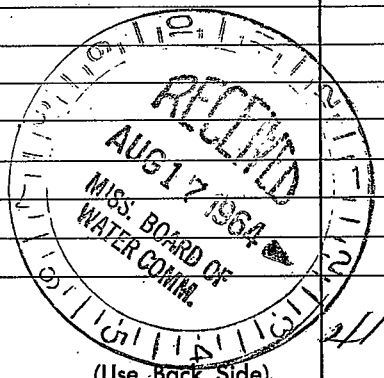

(Use Back Side)

Well No. _____

