

Tallahatchie  
R 7  
5-5-70

MISSISSIPPI  
 BOARD OF WATER COMMISSIONERS  
 416 North State Street  
 Jackson, Mississippi 39201

WATER WELL DRILLERS LOG

May 5 1970 Lipe Well Co. Tallahatchie  
 date well completed firm name county well located

LANDOWNER:  
Robert Earl White  
 (mailing address)  
 WELL LOCATION:  
 sec. 25 T23 N R. 3 E 001  
3 miles S of Cascilla  
 (distance) (direction) (nearest town)

description of formations encountered	from	to
top soil + clay	0	20
clay + sand	20	40
sand + gravel	40	60
sand + clay	60	80
sand + clay	80	100
clay	100	120
clay	120	140
clay + sand	140	160
clay	160	180
clay	180	200
clay	200	220
sand	220	240
sand	240	250

WELL PURPOSE: industrial  
 (home, irrigation, municipal, industrial)

WELL COMPLETION DATA:  
 (1) diameter (inches) 6"  
 (2) total depth (feet) 250'  
 (3) static water level (feet) 125' below above top of ground.  
 (4) casing PVC, 235'  
 (material) (depth)  
6" if telescope see back.  
 (size)  
 (5) screen 15', 235'  
 (length) (depth to top)  
4", PVC + silica  
 (size) (material)  
 (6) pump 5, 60  
 (HP) (yield gpm)  
elec  
 (type power)  
 (7) electric log no  
 (yes or no)  
  
 (organization running log)  
 (8) how well bottom plugged pvc  
screen bottom


DRILLERS REMARKS:

MAY 18 1970

MISS. BD OF  
 WATER COMM.

If well telescopes please sketch and show depths.

GROUND LEVEL

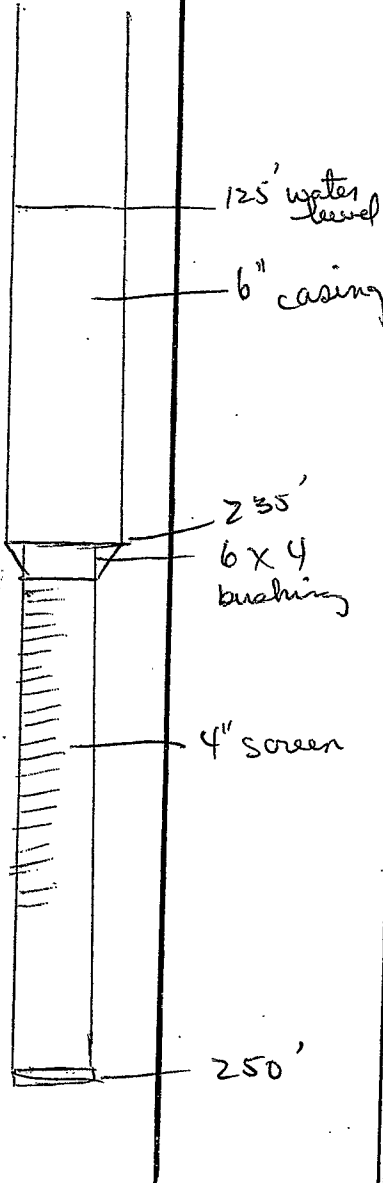

	X		

SECTION 25

Please indicate well location X.

ADDITIONAL INFORMATION

Lined area for additional information.

If more than one screen, show locations of each on sketch.