

MISSISSIPPI
BOARD OF WATER COMMISSIONERS
416 North State Street
Jackson, Mississippi 39201

CODED

R8
TALLAHATCHIE
7-23-73

WATER WELL DRILLERS LOG

Jackson
Tallahatchie

7-23
date well completed


1973 James B. Lipe
firm name

county well located

LANDOWNER:	description of formations encountered	from	to
Catherine Howell Scobey Miss. (mailing address)			
	White Sand	20	100
WELL LOCATION:			
sec. 15 T. 40 N. R. 3 E. 3 miles SE of Scobey, Cassia (distance) (direction) (nearest town)			
WELL PURPOSE: (home, irrigation, municipal, industrial)			
WELL COMPLETION DATA:			
(1) diameter (inches) 4			
(2) total depth (feet) 100			
(3) static water level (feet) 80 below top of ground.			
(4) casing PVC, 90 (material), (depth)			
4 (size) if telescope see back.			
(5) screen 10, 90 (length), (depth to top)			
4, PVC (size), (material)			
(6) pump 3/4, 10 (HP), (yield gpm)			
elec. (type power)			
(7) electric log NO (yes or no)			
NO (organization running log)			
(8) how well bottom plugged PVC plug			
DRILLERS REMARKS:			
JUL 30 1973			

If well telescopes please sketch and show depths.

GROUND LEVEL

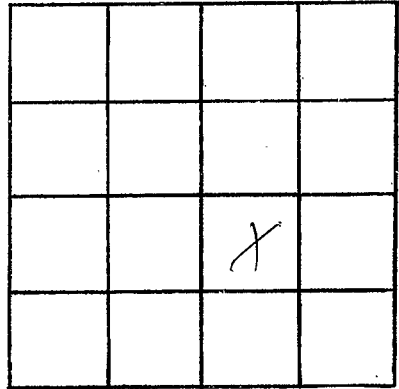

SECTION 15

Please indicate well location X.

ADDITIONAL INFORMATION

A series of horizontal lines for writing additional information.

If more than one screen, show locations of each on sketch.