

Jallahatchie
 R 12
 768

MISSISSIPPI
 BOARD OF WATER COMMISSIONERS
 416 North State Street
 Jackson, Mississippi 39201

CODED

WATER WELL DRILLERS LOG

July 1968 date well completed
 Robert E. Kelly & Co. firm name
 Jallahatchie county well located

LANDOWNER: Karl Nahers
Rosebloom, Miss
 (mailing address)

description of formations encountered	from	to
Top soil & sand	0	21
sandstone	21	43
sandstone & sand	43	64
sand & gravel	64	85
gravel sand	85	109
sand & gravel	109	120

WELL LOCATION:
 sec. 11 T. 230 (N) R. 7 (E)
12 miles North of Opalada
 (distance) (direction) (nearest town)

WELL PURPOSE: home
 (home, irrigation, municipal, industrial)


- WELL COMPLETION DATA:
- (1) diameter (inches) 4"
 - (2) total depth (feet) 120'
 - (3) static water level (feet) 75' ^{below} _{above} top of ground.
 - (4) casing Plastic, 100'
 (material) (depth)
4" if telescope see back.
 (size)
 - (5) screen 20', 100'
 (length) (depth to top)
4" plastic
 (size) (material)
 - (6) pump 3/4 log pump
 (HP) (yield gpm)
electric
 (type power)
 - (7) electric log No
 (yes or no)
 - (8) how well bottom plugged BPD

CODED

DRILLERS REMARKS:

If well telescopes please sketch and show depths.

GROUND LEVEL

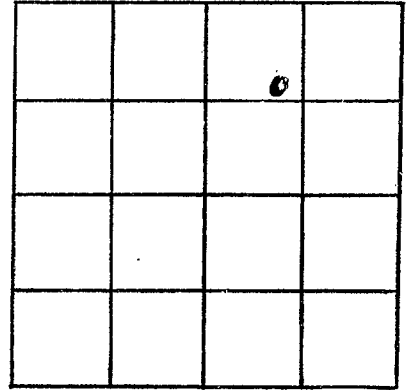

SECTION _____

Please indicate well location X.

ADDITIONAL INFORMATION

27

If more than one screen,
show locations of each on sketch.