

TALLAHATCHIE

R 2000

1-22-76

150

MISSISSIPPI BOARD OF WATER COMMISSIONERS
416 North State Street
Jackson, Mississippi 39201

WATER WELL DRILLERS LOG

Tallahatchie

1-22

1976 Lipe Well Co.

Grenada

date well completed

firm name

county well located

LANDOWNER:

Jackson Chapel
Bart's Church, Grenada
(mailing address)

description of formations encountered

from to

TOP soil	0	20
Sand	20	40
clay and sand	40	60
ll " "	60	80
Sand	80	102

WELL LOCATION:

sec. 2 T 23 (N) R 3 (E)
8 miles N.W. of Grenada
(distance) (direction) (nearest town)

WELL PURPOSE:

(home, irrigation, municipal, industrial)

WELL COMPLETION DATA:

- (1) diameter (inches) 4
- (2) total depth (feet) 102
- (3) static water level (feet) 80 below top of ground.
- (4) casing PVC 92 (material) (depth)
4 (size) If telescope see back.
- (5) screen 10 92 (length) (depth to top)
4 PVC (size) (material)
- (6) pump 3/4 5 (HP) (yield gpm)
elec (type power)
- (7) electric log no (yes or no)
no (organization running log)

(8) how well bottom plugged PVC plug

DECEMBER 1975


FEB 4 - 1976

DRILLERS REMARKS:

MISS. BD. OF WATER COMM

If well telescopes please sketch and show depths.

GROUND LEVEL

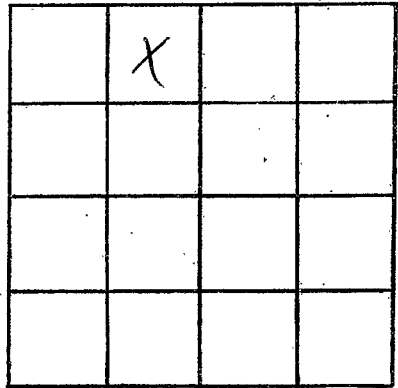

SECTION 2

Please indicate well location X.

ADDITIONAL INFORMATION

If more than one screen,
show locations of each on sketch.