

**MISSISSIPPI
BOARD OF WATER COMMISSIONERS**
416 North State Street
Jackson, Mississippi 39201

WATER WELL DRILLERS LOG

Tallahatchie
R 2001
2-20-80

2-20 1980 Lipe Well Co. Tallahatchie
date well completed firm name county well located

LANDOWNER Gene Farris

Cascilla MS.

(mailing address)

WELL LOCATION:

sec 19 T 23 ^N R 3 ^E
S W
2 miles west of Cascilla
(distance) (direction) (nearest town)

WELL PURPOSE:

(home) irrigation, municipal, industrial)

WELL COMPLETION DATA:

- (1) diameter (inches) 4
- (2) total depth (feet) 220
- (3) static water level (feet) 140 below above
top of ground.
- (4) casing PVC 210
(material) (depth)
4 if telescope see back.
(size)
- (5) screen 10 210
(length) (depth to top)
4 PVC
(size) (material)
- (6) pump 3/4 10
(HP) (yield gpm)
elec.
(type power)
- (7) electric log NO
(yes or no)
N/A
(organization running log)
- (8) how well bottom plugged PVC
cap

description of formations encountered

	from	to
<u>TOP soil</u>	<u>0</u>	<u>20</u>
<u>red clay</u>	<u>20</u>	<u>40</u>
<u>red sand</u>	<u>40</u>	<u>60</u>
<u>Gravel</u>	<u>60</u>	<u>120</u>
<u>clay and sand</u>	<u>120</u>	<u>160</u>
<u>seed sand</u>	<u>160</u>	<u>220</u>

DRILLERS REMARKS:


DEPT. OF NATURAL RESOURCES
BUREAU OF LAND & WATER RESOURCES

MAR 4 - 1980

RECEIVED

If well telescopes please sketch and show depths.

GROUND LEVEL

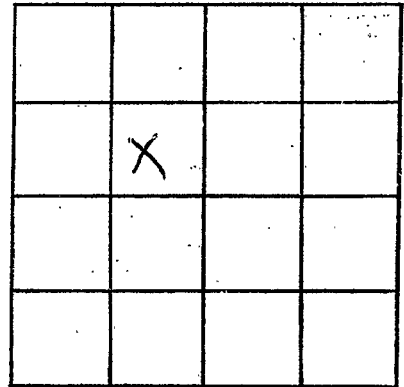

SECTION 19

Please indicate well location X.

ADDITIONAL INFORMATION

If more than one screen,
show locations of each on sketch.