

TALLAHATCHIE
 R 2002
 8/29/80

MISSISSIPPI
 BOARD OF WATER COMMISSIONERS
 416 North State Street
 Jackson, Mississippi 39201

WATER WELL DRILLERS LOG

8-29 date well completed 1980 Lipc Well Co. firm name Tallahatchie county well located

LANDOWNER:	description of formations encountered	from	to
Gene M. Ray	Top soil	0	20
Cascilla MS. (mailing address)	sand	20	40
	Gravel and sand	40	60
	clay	60	100
	clay	100	120
	Gold white sand	120	160
WELL LOCATION: sec. 19 T 23 N R 3 S 2 miles S.W. of Cascilla (distance) (direction) (nearest town)			
WELL PURPOSE: (home irrigation, municipal, industrial)			
WELL COMPLETION DATA:			
(1) diameter (inches) 4"			
(2) total depth (feet) 187			
(3) static water level (feet) 120 below top of ground.			
(4) casing PVC 177' (material) (depth)			
4 (size) if telescope see back.			
(5) screen 10 177' (length) (depth to top)			
4 PVC (size) (material)			
(6) pump 3/4 10 (HP) (yield gpm)			
elec. (type power)			
(7) electric log 10 (yes or no)			
N.R. (organization running log)			
(8) how well bottom plugged PVC cap			
DRILLERS REMARKS:			


DEPT. OF NATURAL RESOURCES
 BUREAU OF LAND & WATER RESOURCES

OCT 16 1980

RECEIVED

If well telescopes please sketch and show depths.

GROUND LEVEL

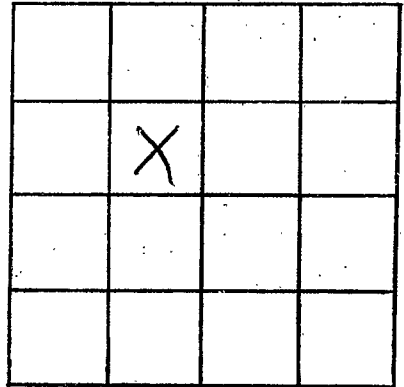

SECTION 19

Please indicate well location X.

ADDITIONAL INFORMATION

If more than one screen,
show locations of each on sketch.