

Talkeharhia
R 2003

MISSISSIPPI
BOARD OF WATER COMMISSIONERS
416 North State Street
Jackson, Mississippi 39201

WATER WELL DRILLERS LOG

3/23/89 1989 Lipa Well Supply firm name Talkeharhia county well located

LANDOWNER: Bob Taylor
Charles Low
Miss
(mailing address)

description of formations encountered	from	to
<u>clay</u>	<u>0</u>	<u>10</u>
<u>sand</u>	<u>10</u>	<u>172</u>

WELL LOCATION:
sec. 16 T 23 S R 3 W of Cocite
(distance) miles (direction) (nearest town)

WELL PURPOSE:
(home, irrigation, municipal, industrial)

WELL COMPLETION DATA:

(1) diameter (inches) 4

(2) total depth (feet) 179

(3) static water level (feet) 90 below above top of ground.

(4) casing PVC, 169,
(material) (depth),
4 if telescope see back.
(size)

(5) screen 10, 169
(length) (depth to top)
4, PVC
(size) (material)

(6) pump 3 35
(HP) (yield gpm)
ele
(type power)

(7) electric log X
(yes or no)

(organization running log)

(8) how well bottom plugged PVC cap

DEPT. OF NATURAL RESOURCES
BUREAU OF LAND & WATER RESOURCES


APR 23 1984

RECEIVED

DRILLERS REMARKS:

If well telescopes please sketch and show depths.

GROUND LEVEL

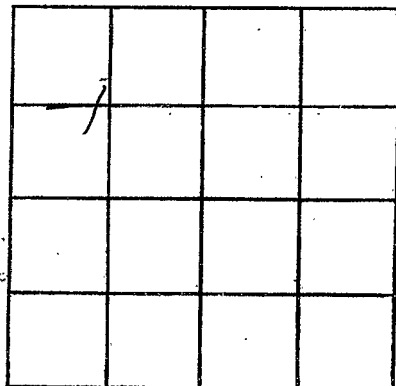

SECTION _____

Please indicate well location X.

ADDITIONAL INFORMATION

If more than one screen,
show locations of each on sketch.