


MISSISSIPPI DEPARTMENT OF NATURAL RESOURCES
 Bureau of Land and Water Resources
 Southport Mall
 P.O. Box 10631
 Jackson, Mississippi 39209
WATER WELL DRILLERS LOG

Paulina
R 2004

1-19 1991 LIFE WELL & SUPPLY CO., INC. Tallahatchie
 date well completed firm name county well located

LANDOWNER: <u>Doyle Kendall</u>	description of formations encountered	from	to
		<u>Casilla, ms.</u> (mailing address)	Clay
WELL LOCATION: sec. <u>12</u> T. <u>23</u> N. R. <u>3</u> E <u>3</u> miles <u>South</u> of <u>ROSEBLOOM</u> (distance) (direction) (nearest town)	Clay	20	30
WELL PURPOSE: <u>HOME</u> (home, irrigation, municipal, industrial)	Sand	30	40
WELL COMPLETION DATA: (1) diameter (inches) <u>4"</u>	Sand	40	60
(2) total depth (feet) <u>180</u>	Sand	60	80
(3) static water level (feet) _____ below above top of ground.	SAND STREAK	80	100
(4) casing <u>PVC</u> , <u>170</u> (material) (depth)	Sand	100	110
<u>4"</u> (size) if telescope see back.	Clay	110	120
(5) screen <u>10</u> , <u>170</u> (length) (depth to top)	Clay	120	140
<u>4</u> , <u>PVC</u> (size) (material)	Clay STREAK	140	155
(6) pump <u>3/4</u> (HP) (yield gpm)	Sand	155	160
(type power) _____	Sand STREAK at B.	160	180
(7) electric log <u>(yes or no)</u>			
(organization running log) _____			
(8) how well bottom plugged <u>Capped</u>			
DRILLERS REMARKS: _____			

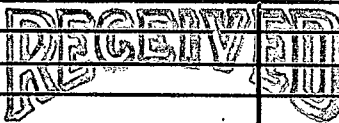


APR 18 1991

Dept. of Environmental Quality
 Bureau of Land & Water Resources

If well telescopes please sketch and show depths.

GROUND LEVEL

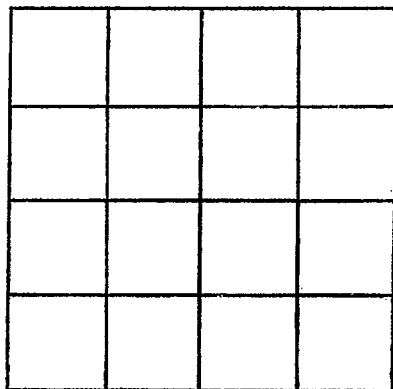

SECTION _____

Please indicate well location X.

ADDITIONAL INFORMATION

If more than one screen, show locations of each on sketch.