

Tallahatchie
 533
 5-8-74

MISSISSIPPI
 BOARD OF WATER COMMISSIONERS
 416 North State Street
 Jackson, Mississippi 39201
 CODED

WATER WELL DRILLERS LOG

5/8/74 19 BUTANE GAS CO. OF GREENWOOD Tallahatchie
 date well completed firm name county well located

LANDOWNER:
 Falls Farms
 Winter City, Miss.
 (mailing address)


description of formations encountered	from	to
CLAY	0	10
SAND	10	30
SAND & GRAVEL	30	80

WELL LOCATION:
 sec. 25 T. 24 N. R. 1 E
 2 1/2 miles W of Phillip
 (distance) (direction) (nearest town)

WELL PURPOSE: FARM
 (home, irrigation, municipal, industrial)

- WELL COMPLETION DATA:
- (1) diameter (inches) 4"
 - (2) total depth (feet) 80'
 - (3) static water level (feet) 10' below top of ground.
 - (4) casing PVC 50' (material), 4" (size) if telescope see back.
 - (5) screen 30' (length), 50' (depth to top), 4" (size), PVC (material)
 - (6) pump 3 (HP), 100 (yield gpm), Elec (type power)
 - (7) electric log No (yes or no)
- (organization running log)
- (8) how well bottom plugged PVC CAP

CODED

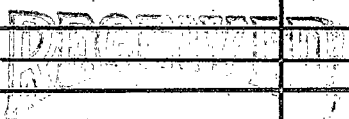

MAY 28 1974

DRILLERS REMARKS:

