

Tallahatchie

S 34

4-30-74

MISSISSIPPI
 BOARD OF WATER COMMISSIONERS CODED
 416 North State Street
 Jackson, Mississippi 39201

WATER WELL DRILLERS LOG

April 30 1974
date well completed

74 Leitha Kelly Johnson
firm name

Tallahatchie
county well located

LANDOWNER:	description of formations encountered	from	to
James Buchanan Phillip, Mississippi (mailing address)			
WELL LOCATION: sec. 14 T 22 N R 1 E S W 1 1/2 miles east of Phillip (distance) (direction) (nearest town)			
WELL PURPOSE: home (home, irrigation, municipal, industrial)			
WELL COMPLETION DATA:			
(1) diameter (inches) 4 1/2"			
(2) total depth (feet) 708'			
(3) static water level (feet) 3' below top of ground.			
(4) casing galv. 688' (material) (depth)			
4x2 if telescope see back. (size)			
(5) screen 20' 688' (length) (depth to top)			
2" stainless steel (size) (material)			
(6) pump 1/2 HP - 20 gal (HP) (yield gpm)			
(type power)			
(7) electric log no (yes or no)			
(organization running log)			
(8) how well bottom plugged backwash			
DRILLERS REMARKS:			

CODED

RECEIVED
JUL 12 1974

MISS. DD. OF WATER COMM


If well telescopes please sketch and show depths.

GROUND LEVEL

136'
4"
galv
pipe

362'
2"
galv
pipe

90'
stainless
steel
2"

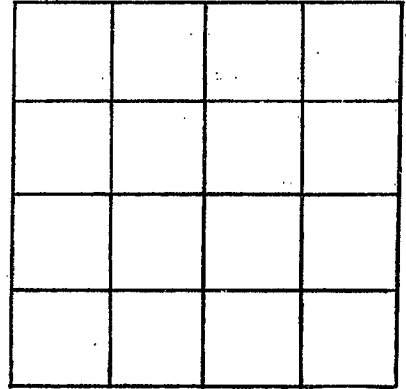

SECTION _____

Please indicate well location X.

ADDITIONAL INFORMATION

A series of horizontal lines for recording additional information.

If more than one screen, show locations of each on sketch.