

Tallahatchee

S35

5-9-74

MISSISSIPPI BOARD OF WATER COMMISSIONERS
416 North State Street
Jackson, Mississippi 39201

CODED

WATER WELL DRILLERS LOG

May 9 1974
date well completed

Guthrie Rattiff & Sons
firm name

Tallahatchee
county well located

LANDOWNER: P. G. Blake
Phillips, Miss.

(mailing address)

WELL LOCATION:

sec. 14 T 22N R 1 E
S W
1 1/2 miles east of Phillips
(distance) (direction) (nearest town)

WELL PURPOSE: home
(home, irrigation, municipal, industrial)

WELL COMPLETION DATA:

- (1) diameter (inches) 2"
- (2) total depth (feet) 708'
- (3) static water level (feet) 3' below top of ground.
- (4) casing galv. 688' (material) (depth)
- (5) screen 20' 688' (length) (depth to top)
2" stainless steel (size) (material)
- (6) pump Flowing 30 gal (HP) (yield gpm)
- (7) electric log no (yes or no)

(organization running log)

(8) how well bottom plugged
back wash valve

DRILLERS REMARKS:

description of formations encountered

from

to

Top - Lumber	0	16
Sand	16	70
Sand & Gravel	70	140
Clay & Shale 36	140	350
Sand	350	410
Shale & Sand	410	650
Sand	650	708

CODED


RECEIVED

JUL 12 1974

MISS. BD. OF WATER COMM.

If well telescopes please sketch and show depths.

GROUND LEVEL

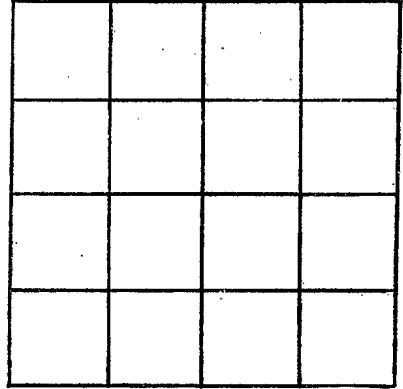

SECTION _____

Please indicate well location X.

ADDITIONAL INFORMATION

If more than one screen, show locations of each on sketch.