

TALLAHATCHIE

536
10-66

MISSISSIPPI BOARD OF WATER COMMISSIONERS
CODED

WATER WELL DRILLERS LOG

Date: 10/4, 1966, Driller: Luther Ratliff County Tallahatchie
(When well drilled) (Name) (Where well is located)

(1) Owner of Land: Robert Johnson
(Name)
Phillips, Miss.
(Address)
(2) Location: NW 1/4, NW 1/4, Sec. 1B T22R1E
2 miles NE of Phillips
(distance) (direction) (Nearest Town)
(3) Topography: _____
(Hilly) (Flat) (Level)
(4) Purpose of Well: Home
(Domestic Irrigation
Municipal, Industrial, Other)


Description & Color of Materials Sand, Clay, Red Clay, Shell, etc.	Thick- ness Feet	Depth Feet
0-23 clay & sand		
23-43 sand		
43-63 sand		
63-83 sand & gravel		
83-103 gravel & sand		
103-123 gravel		
123-143 gravel & sand		
143-163 sand		
163-183 CODED		
183-203 sand & shale		
203-223 shale		
223-243 shale		
243-263 shale & sand		
263-283 shale		
283-303 shale		
303-323 shale & sand		
323-343 sand streak		
343-363 shale		
363-383 shale & sand		
383-403 clay & sand streak		
403-423 sand streak		
423-443 clay & sand streak		
443-463 clay		
463-483 clay		
483-503 clay		
503-523 clay & sand		
523-543 sand		
543-563 sand		
563-583 clay & sand streak		
583-603 sand		
603-623 sand		
623-650 sand		

Information upon completion of well:

(1) Diameter 2 inches.
(2) Total Depth 650 feet.
(3) Water Level Flowing feet below top of ground.
(4) Cased to 650, Size 2"
(5) Screen: Size 10 slot, Length 20'
(6) Were any formations sealed against pollution?
_____ yes, _____ no.

If YES depth of formation _____
Why _____

Drillers Remarks: _____
Yield in gpm: 15
Size pump: _____
Type power: Flow

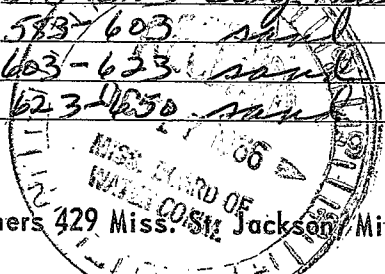

Mail this copy to Board of Water Commissioners 429 Miss. State Jackson, Miss.

