

TALLAHATCHIE  
 S37  
 10-67

MISSISSIPPI  
 BOARD OF WATER COMMISSIONERS  
 416 North State Street  
 Jackson, Mississippi 39201

CODED

WATER WELL DRILLERS LOG

Oct 24 1967 Luther Ratliff Tallahatchie  
 date well completed firm name county well located

LANDOWNER: Lee Jones

description of formations encountered	from	to
Clay	0	25
Gravel & Sand	25	127
Clay	127	147
Sand	147	167
Sand Struck	167	207
Clay	207	287
Clay & Rock	287	367
Gravel	367	387
S shale	387	487
Sand	487	547
S CODED	547	627
Sand	627	671


Phillips Miss  
 (mailing address)

WELL LOCATION:  
 sec 21 T 22N R 1 E  
1/4 miles South of Phillip  
 (distance) (direction) (nearest town)

WELL PURPOSE: Dom  
 (home, irrigation, municipal, industrial)


- WELL COMPLETION DATA:
- (1) diameter (inches) 2"
  - (2) total depth (feet) 671
  - (3) static water level (feet) Flow below above top of ground:
  - (4) casing Galv, 671  
 (material) (depth)  
2" if telescope see back.  
 (size)
  - (5) screen 20, Standar Steel  
 (length) (depth to top)  
2" (size) (material)
  - (6) pump 20, Flow  
 (HP) (yield gpm)  
 (type power)
  - (7) electric log No  
 (yes or no)  
 (organization running log)
  - (8) how well bottom plugged Back  
Wash Valve

DRILLERS REMARKS:

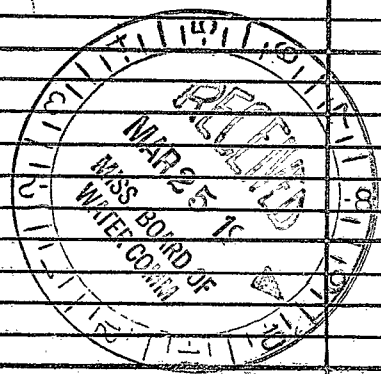

If well telescopes please sketch and show depths.

GROUND LEVEL

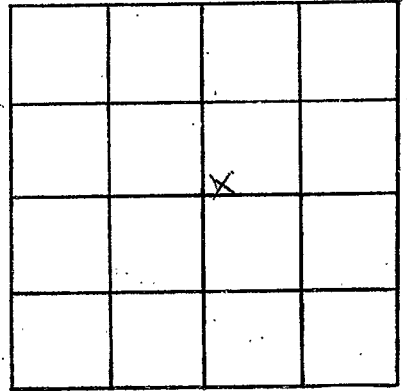

SECTION 21

Please indicate well location X.

ADDITIONAL INFORMATION

If more than one screen, show locations of each on sketch.