

Tallahatchie
 531
 4/14/78

MISSISSIPPI
 BOARD OF WATER COMMISSIONERS
 416 North State Street
 Jackson, Mississippi 39201

CODED

WATER WELL DRILLERS LOG
 BUTANE GAS COMPANY

4-14-78 19
 date well completed

OF GREENWOOD
 firm name

Tallahatchie
 county well located

LANDOWNER:
 H. C. Strider, JR.
 Charleston
 (mailing address)

WELL LOCATION:
 sec. 3 T 22 N R. 1 E
4 miles NE of Philipp
 (distance) (direction) (nearest town)

WELL PURPOSE: Home
 (home, irrigation, municipal, industrial)

- WELL COMPLETION DATA:
- (1) diameter (inches) 4 X 3
 - (2) total depth (feet) 672
 - (3) static water level (feet) 10 below above top of ground.
 - (4) casing Steel, 632
 (material) (depth)
4 X 3 if telescope see back.
 (size)
 - (5) screen 40', 632
 (length) (depth to top)
2", Stainless
 (size) (material)
 - (6) pump 2 40
 (HP) (yield gpm)
Elec.
 (type power)
 - (7) electric log No
 (yes or no)
- (organization running log)

(8) how well bottom plugged
Back Pressure Valve

DRILLERS REMARKS:


description of formations encountered	from	to
Clay	0	10
SAND	10	50
SAND & GRAVEL	50	118
CLAY	118	180
Silt & Rock	180	290
Sandy Silt	290	340
Silt	340	385
SAND & Silt CODED	385	400
Silt	400	495
Sandy Silt	495	560
Silt	560	605
Fine Sand	605	632
Silt	632	635
SAND	635	678

RECEIVED
 APR 24 1978

MISS. BD. OF WATER COMM

If well telescopes please sketch and show depths.

GROUND LEVEL

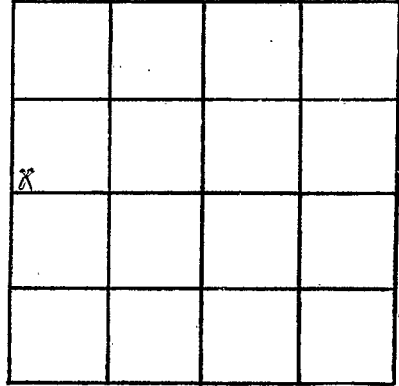

SECTION 2

Please indicate well location X.

ADDITIONAL INFORMATION

If more than one screen, show locations of each on sketch.