

Tallahatchie
 S 41
 12/7/78

MISSISSIPPI
 BOARD OF WATER COMMISSIONERS
 416 North State Street
 Jackson, Mississippi 39201

CODED

WATER WELL DRILLERS LOG

December 7, 1978 Dyer Well & Irrigation Tallahatchie
 date well completed firm name county well located

LANDOWNER: Corps of Engineers
 Tipso Channel Project - Tippa, Miss.
 Vicksburg, Miss.
 (mailing address)

description of formations encountered	from	to
Clay	0	18
FINE SAND	18	28
SAND	28	43
SAND + GRAVEL CODED	43	63
SAND	63	75
SAND + GRAVEL	75	103
Bottom		103

WELL LOCATION:
 sec. 12 T. 28 N. R. 1 E
 S W
 4 miles East of Phillip
 (distance) (direction) (nearest town)

WELL PURPOSE: Industrial
 (home, irrigation, municipal, industrial)

- WELL COMPLETION DATA:
- (1) diameter (inches) 16"
 - (2) total depth (feet) 103'
 - (3) static water level (feet) 11" below above top of ground.
 - (4) casing STEEL, 63' (material) (depth)
 16" (size) if telescope see back.
 - (5) screen 40' (length), 63' (depth to top)
 16" (size), STEEL (material)
 - (6) pump 60 (HP), 3000 (yield gpm)
 DIESEL (type power)
 - (7) electric log No (yes or no)
 (organization running log)
 - (8) how well bottom plugged Plate


Miss. Board of Water Comm.
 FEB 8 1979

DRILLERS REMARKS:

RECEIVED

If well telescopes please sketch and show depths.

GROUND LEVEL

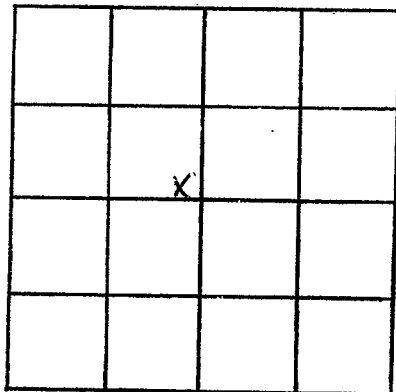

SECTION 12

Please indicate well location X.

ADDITIONAL INFORMATION

A series of horizontal lines for writing additional information, starting below the 'ADDITIONAL INFORMATION' header and extending down to the bottom of the page.

If more than one screen, show locations of each on sketch.