

Tallahatchie  
S 43  
CL-1680  
11/8/80

MISSISSIPPI  
BOARD OF WATER COMMISSIONERS  
416 North State Street  
Jackson, Mississippi 39201

CODED

WATER WELL DRILLERS LOG

11-8-80 19 Layne-Central Company Tallahatchie  
date well completed firm name county well located

LANDOWNER:	description of formations encountered	from	to
J. W. Fennell Philipp, MS (mailing address)			
WELL LOCATION: sec. 28 T 22 N R 1 E S W 5 miles S of Philipp (distance) (direction) (nearest town)	Fine Sand	14	22
	Fine Sand	22	32
	Coarse Sand	32	42
	Coarse Sand	42	52
	Coarse Sand	52	62
	Coarse sand & Gr.	62	72
	Coarse sand & Gr.	72	82
	Coarse sand & Gr.	82	92
	Clay	92	96
	WELL PURPOSE: irrigation (home, irrigation, municipal, industrial)		
WELL COMPLETION DATA:			
(1) diameter (inches) 32"			
(2) total depth (feet) 92'			
(3) static water level (feet) 27 below above top of ground.			
(4) casing Steel, 52' (material) (depth)			
16" (size) if telescope see back.			
(5) screen 40' (length), 52' (depth to top)			
16" (size), St. Steel (material)			
(6) pump 60 (HP), 2800 (yield gpm)			
electric (type power)			
(7) electric log no. (yes or no)			
(organization running log)			
(8) how well bottom plugged St. plate			
DRILLERS REMARKS:			


DEPT. OF NATURAL RESOURCES  
BUREAU OF LAND & WATER RESOURCES

FEB 19 1981

RECEIVED

If well telescopes please sketch and show depths.

GROUND LEVEL

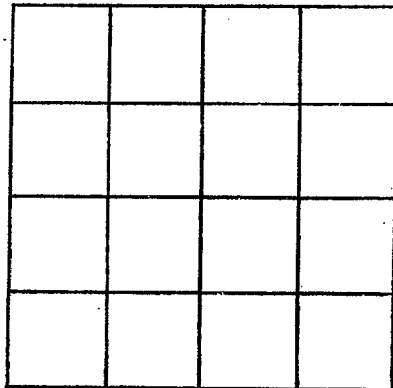

SECTION \_\_\_\_\_

Please indicate well location X.

ADDITIONAL INFORMATION

If more than one screen,  
show locations of each on sketch.