

MISSISSIPPI DEPARTMENT OF NATURAL RESOURCES

Bureau of Land and Water Resources

Southport Mall

P.O. Box 10631

Jackson, Mississippi 39209

WATER WELL DRILLERS LOG **CODED**

BUTANE GAS CO. OF GREENWOOD

Tallahatchie


Tallahatchie  
S 44  
3/12/81  
13-12-81

date well completed

firm name

county well located

LANDOWNER:	description of formations encountered	from	to
J.W. Fennell	CLAY	0	15
Philipp	SAND	15	50
(mailing address)	SAND + PER GRAVEL	50	60
WELL LOCATION:	SAND + GRAVEL	60	110
sec. <u>28</u> T <u>22</u> N R <u>1</u> E			
<u>1</u> miles <u>S</u> of <u>Philipp</u>			
(distance) (direction) (nearest town)			
WELL PURPOSE: <u>IRR</u>	<b>CODED</b>		
(home, irrigation, municipal, industrial)			
WELL COMPLETION DATA:			
(1) diameter (inches) <u>16"</u>			
(2) total depth (feet) <u>110</u>			
(3) static water level (feet) <u>20</u> below top of ground.			
(4) casing <u>Steel</u> , <u>70</u> , (material) (depth)			
<u>16"</u> (size) If telescope see back.			
(5) screen <u>40</u> , <u>70</u> (length) (depth to top)			
<u>16</u> , <u>Steel</u> (size) (material)			
(6) pump <u>60</u> , <u>2500</u> (HP) (yield gpm)			
<u>Direct</u> (type power)			
(7) electric log <u>No</u> (yes or no)			
(organization running log)			
(8) how well bottom plugged <u>Steel Plate</u>			
DRILLERS REMARKS:			

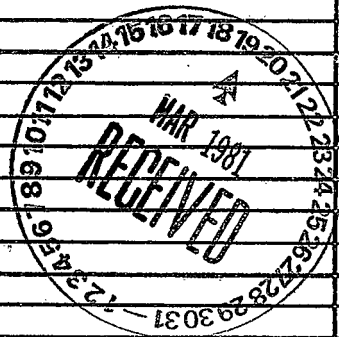


DEPT. OF NATURAL RESOURCES  
BUREAU OF LAND & WATER RESOURCES

MAR 19 1981

**RECEIVED**

If well telescopes please sketch and show depths.

GROUND LEVEL

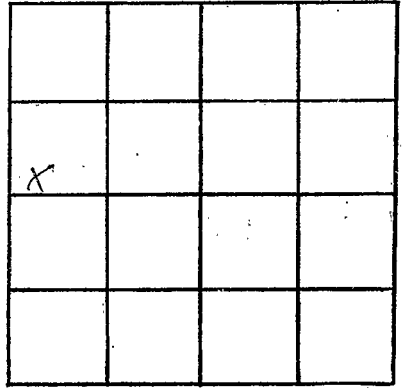

SECTION 27

Please indicate well location X.

ADDITIONAL INFORMATION

If more than one screen,  
show locations of each on sketch.