

MISSISSIPPI DEPARTMENT OF NATURAL RESOURCES

Bureau of Land and Water Resources

Southport Mall

P.O. Box 10631

CODED

Jackson, Mississippi 39209

WATER WELL DRILLERS LOG

BUTANE GAS COMPANY

OF GREENWOOD  
firm name

Tallahatchie  
county well located

S46  
Tallahatchie  
5-20-84

5-20 1984  
date well completed

LANDOWNER: J. W. Fenell  
Monte City - Phillip  
(mailing address)

| description of formations encountered | from | to  |
|---------------------------------------|------|-----|
| CLAY                                  | 0    | 15  |
| FINE SAND                             | 15   | 45  |
| same clay                             | 45   | 65  |
| SAND + gravel                         | 65   | 105 |

WELL LOCATION:  
sec. 28 T. 22 N. R. 1 E  
S W  
2 miles SE of Phillip  
(distance) (direction) (nearest town)

WELL PURPOSE: IRRIGATION  
(home, irrigation, municipal, industrial)

- WELL COMPLETION DATA:
- (1) diameter (inches) 8"
  - (2) total depth (feet) 105
  - (3) static water level (feet) 20' below top of ground.
  - (4) casing Steel, 65'  
(material) (depth)
  - 8" If telescope see back.  
(size)
  - (5) screen 40', 65'  
(length) (depth to top)
  - 8", Steel  
(size) (material)
  - (6) pump 15, 1000  
(HP) (yield gpm)
  - Electric  
(type power)
  - (7) electric log No  
(yes or no)
  - No  
(organization running log)
  - (8) how well bottom plugged Steel plate

DEPT. OF NATURAL RESOURCES  
BUREAU OF LAND & WATER RESOURCES


JUN - 4 1984

RECEIVED

DRILLERS REMARKS:  
Richard

If well telescopes please sketch and show depths.

GROUND LEVEL

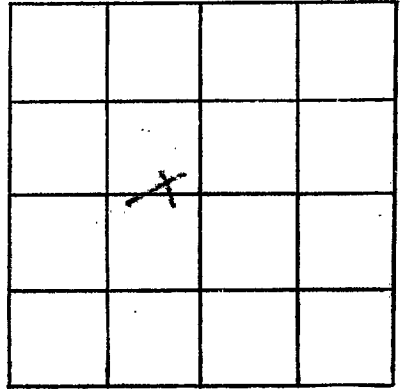

SECTION 28

Please indicate well location X.

ADDITIONAL INFORMATION

If more than one screen,  
show locations of each on sketch.