

MISSISSIPPI DEPARTMENT OF NATURAL RESOURCES

Bureau of Land and Water Resources

Southport Mall

P.O. Box 10631

Jackson, Mississippi 39209 **CODED**

WATER WELL DRILLERS LOG

Tallahatchie
S47

6-3 date well completed 1987 J L KIRKISATIA firm name Tallahatchie county well located

LANDOWNER: H.C. Strider
Phillip, Miss

description of formations encountered

from to

| | | |
|----------------------|----|-----|
| Clay | 0 | 17 |
| Fine Sand | 17 | 40 |
| Coarse Sand & Gravel | 40 | 105 |

(mailing address)

WELL LOCATION:

sec 23 T 22 N R I E
4 miles E of Phillip
(distance) (direction) (nearest town)

CODED

WELL PURPOSE: Irrigation
(home, irrigation, municipal, industrial)

WELL COMPLETION DATA:

- (1) diameter (inches) 16"
- (2) total depth (feet) 105
- (3) static water level (feet) 14 below top of ground.
- (4) casing Steel, 25'
(material) (depth)
16" if telescope see back.
(size)
- (5) screen 40', 25'
(length) (depth to top)
16", Steel
(size) (material)
- (6) pump 60 2500
(HP) (yield gpm)
Diesel
(type power)
- (7) electric log no
(yes or no)

RECEIVED

JUN 30 1987

(organization running log)


(8) how well bottom plugged PLATE

Department of Natural Resources
Bureau of Land & Water Resources

DRILLERS REMARKS:

If well telescopes please sketch and show depths.

GROUND LEVEL

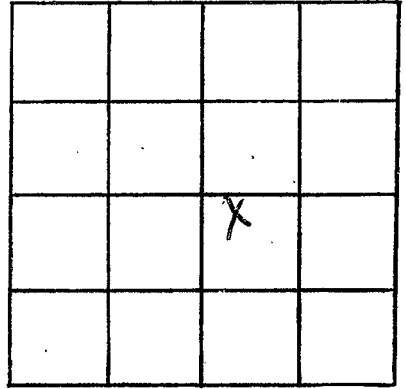

SECTION 23

Please indicate well location X.

ADDITIONAL INFORMATION

If more than one screen,
show locations of each on sketch.