

Tallahatchie
548

MISSISSIPPI DEPARTMENT OF NATURAL RESOURCES
 Bureau of Land and Water Resources
 Southport Mall
 P.O. Box 10631
 Jackson, Mississippi 39209
WATER WELL DRILLERS LOG

1
CODED

6-11 1987 J & K Irrigation Tallahatchie
 date well completed firm name county well located

LANDOWNER: H.C. Stidder
Phillip, Miss

description of formations encountered	from	to
<u>CLAY</u>	<u>0</u>	<u>17</u>
<u>FINE SAND</u>	<u>17</u>	<u>42</u>
<u>COURSE SAND & GRAVEL</u>	<u>42</u>	<u>117</u>

(mailing address)

WELL LOCATION:
 sec 26 T 22 N R 1 E
4 miles SE of Phillip
 (distance) (direction) (nearest town)

CODED

WELL PURPOSE: INDICATOR
 (home, irrigation, municipal, industrial)

WELL COMPLETION DATA:

- (1) diameter (inches) 16"
- (2) total depth (feet) 117
- (3) static water level (feet) 16 below above top of ground.
- (4) casing Steel, 87,
 (material) (depth)
16" if telescope see back.
 (size)
- (5) screen 40', 87
 (length) (depth to top)
16", Steel
 (size) (material)
- (6) pump 60 2800
 (HP) (yield gpm)
Electric
 (type power)
- (7) electric log NO.
 (yes or no)

RECEIVED

JUN 30 1987

Department of Natural Resources
 Bureau of Land & Water Resources

(organization running log)


(8) how well bottom plugged PLATE

DRILLERS REMARKS:

If well telescopes please sketch and show depths.

GROUND LEVEL

If more than one screen, show locations of each on sketch.

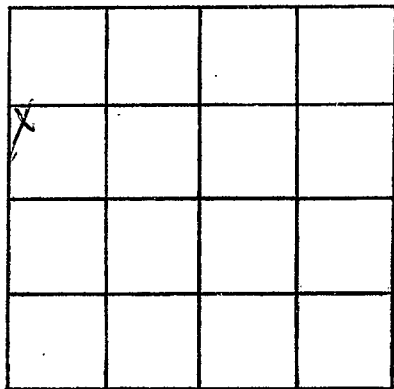

SECTION 26

Please indicate well location X.

ADDITIONAL INFORMATION