


TALLAHATCHIE
 22-3607
 549

Colod

MISSISSIPPI DEPARTMENT OF NATURAL RESOURCES
 Bureau of Land and Water Resources
 Southport Mall
 P.O. Box 10631
 Jackson, Mississippi 39209
WATER WELL DRILLERS LOG

6-11 19 87 LAYNE-CENTRAL CO. TALLAHATCHIE
 date well completed firm name county well located

| LANDOWNER: | description of formations encountered | from | to |
|---|---------------------------------------|------------------------|-----|
| HANCOCK INSURANCE | | | |
| CLEVELAND, MS 38732 | LIGNITE SAND | 14 | 30 |
| (mailing address) | GRAVEL SAND | 30 | 104 |
| | CLAY | 104 | 106 |
| WELL LOCATION: | | | |
| sec. 14 T-22 N R-1 E | | | |
| 3 miles E of PHILIPP | | | |
| (distance) (direction) (nearest town) | | | |
| WELL PURPOSE: IRRIGATION | | | |
| (home, irrigation, municipal, industrial) | | | |
| WELL COMPLETION DATA: | | | |
| (1) diameter (inches) | 16" | | |
| (2) total depth (feet) | 104' | | |
| (3) static water level (feet) | 15' below top of ground. | | |
| (4) casing | STEEL | 64' | |
| | (material) | (depth) | |
| | 16" | if telescope see back. | |
| | (size) | | |
| (5) screen | 40' | 64' | |
| | (length) | (depth to top) | |
| | 16" | ST. STEE. | |
| | (size) | (material) | |
| (6) pump | 60 | 2000 | |
| | (HP) | (yield gpm) | |
| | DIESEL | | |
| | (type power) | | |
| (7) electric log | NO | | |
| | (yes or no) | | |
| | (organization running log) | | |
| (8) how well bottom plugged | ST. PLATE | | |

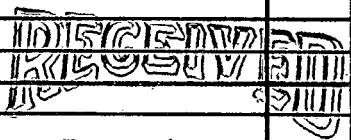


FEB 01 1988

Department of Natural Resources
 Bureau of Land & Water Resources

DRILLERS REMARKS:

If well telescopes please sketch and show depths.

GROUND LEVEL

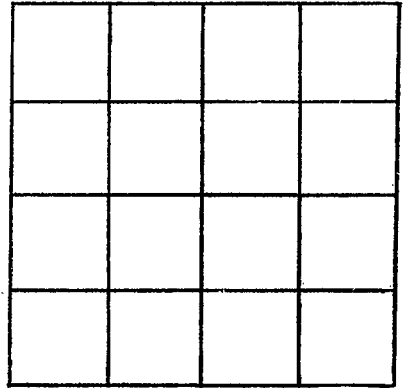

SECTION _____

Please indicate well location X.

ADDITIONAL INFORMATION

If more than one screen,
show locations of each on sketch.