

TEP#
 11296-RES
 081788
 S 51

CODED

MISSISSIPPI DEPARTMENT OF NATURAL RESOURCES
 Bureau of Land and Water Resources
 Southport Mall
 P.O. Box 10631
 Jackson, Mississippi 39209
 WATER WELL DRILLERS LOG

6-25 1988 Dyer Well Tallahatchie
 date well completed firm name county well located

LANDOWNER: Frank Sturdivant
 (mailing address)

WELL LOCATION:
 sec. 4-21 N R. 1-8
 6 miles S of Minter City
 (distance) (direction) (nearest town)

WELL PURPOSE: Irrigation
 (home, irrigation, municipal, industrial)

- WELL COMPLETION DATA:
- (1) diameter (inches) 16"
 - (2) total depth (feet) 117'
 - (3) static water level (feet) _____ below/above top of ground.
 - (4) casing steel (material), (depth) 16" (size) if telescope see back.
 - (5) screen 40' (length), (depth to top) 16" (size), (material)
 - (6) pump 60 (HP), (yield gpm) Gear (type power)
 - (7) electric log No (yes or no) None (organization running log)
 - (8) how well bottom plugged Plate

description of formations encountered	from	to
Clay	0	28
Fine Sand	28	45
F Sand + Gravel	45	60
M Sand + Gravel	60	80
F Sand + Gravel	80	85
M Sand + Gravel	85	90
Sand + Gravel	90	107
Fine Sand	107	117

RECEIVED


JUL 11 1988

DRILLERS REMARKS:

Department of Natural Resources
 Bureau of Land & Water Resources

If well telescopes please sketch and show depths.

GROUND LEVEL

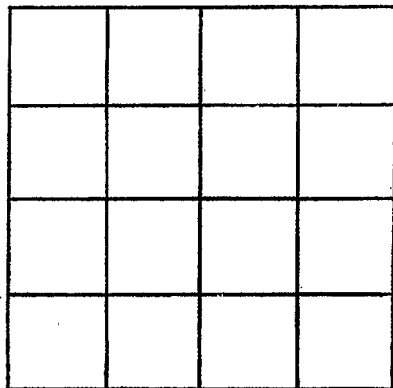

SECTION _____

Please indicate well location X.

ADDITIONAL INFORMATION

If more than one screen,
show locations of each on sketch.