County:	Tallahatchie		
Permit #: Irri Driller:	MS6W gation	<i>40464</i> Equipment	
_	ing completed:	7-20-05	

State Well Report

Part 1

Mississippi Department of Environmental Quality
Office of Land and Water Resources
P.O. Box 10631
Jackson, MS 39289-0631
(601)961-5210
(601)354-6938 (fax)

For Office Use Only:		
Aquifer:		
Well #: 5-172		
L. S. Elevation:		
E-log #:		

State Law requires that this report be prepared by the driller in detail and filed with the Department within 30 days of completion of drilling of the well

30 days of completion of drilling of the well.	
Well Owner Information	Well Location
Owner Name Gregory Properties, LLC	Latitude:o Longitude:o
Mailing Address: 1505 Gale Lane	Method of Lat/Long (circle one): Conventional Survey,
	USGS quad, Hand-held GPS, Survey-grade GPS
	NW _{1/4} NW _{1/4} Sec 27 Twn 22N Rng 1E
Nashville, TN 37212	7474 Sec 1wii Ring
City State Zip Code	Distance Direction Nearest Town
Telephone No. (662-647-2623	
Contact Person: Gerry Speir	
Well I)ata
Purpose of Well (circle one) Home Industrial Public Supply	rigation Fish Culture Other:
Date well drilling started: 7-20-05 Date v	well drilling completed: 7-20-05
If flowing, method of flow regulation: Valve Other (d	escribe)
Static Water Level: 14' feet above or below (circle one) l	and surface Date measured: $7-20-05$
Method of Measurement (circle one) teel tape electric tape	air line other:
Hole depth: 117' Well depth: 117'	Well grouted to a depth offeet
Type of grout (circle one): Cement Bentonite Mix	
Casing length: 77 feet Casing diameter: 16	_inches Type of casing: PVC Sch. 40
Screen length: 40 feet Screen diameter: 16	_inches Type of screen: PVC Sch. 40
Screen slot size: 050_inches Setting depth: From	78feet to117feet
Type of completion (circle all applicable): Gravel packed Under	reamed Telescoped Open hole Natural Development
Other (describe):	
Top of lap pipe or reduction in casing:feet. If tel	escoped or more than one screen, describe on back of page
Logs run (circle all applicable): No log run Electric Gamma Ray	Density Sonic Neutron Other:
Name of organization running log(s):	
I certify that the well was drilled, constructed, and completed in a	ccordance with all applicable requirements of the Mississippi
Department of Environmental Quality and/or the Mississippi Dep	artment of Health regulations and state laws,
Irrigation Equipment Inc.	by mall
Patrick M. Chism 0695	Yalnele III Cham
Print Name of Water Well Contractor and License No.	Signature of Water Well Contractor

RECEIVED


AUG 0 1 2005

BY OLWA

Ground Level

Description of Formations Encountered	From	To
Clay	0	18
Clay Fine Sand	19	28
Fine sand/gravel	29	41
Fine sand/gravel Med. Sand/gravel	42	117
34.75	1	
	<u> </u>	
	†	\vdash
	 	1
	 	┼┤
		+
	 	-
	 	1
	<u> </u>	
	ļ	1
	<u> </u>	
	<u> </u>	
	1	T
	1	1
		1
	 	
	1	
	+	+
	Ь	1

If more than one screen, show location of each on sketch

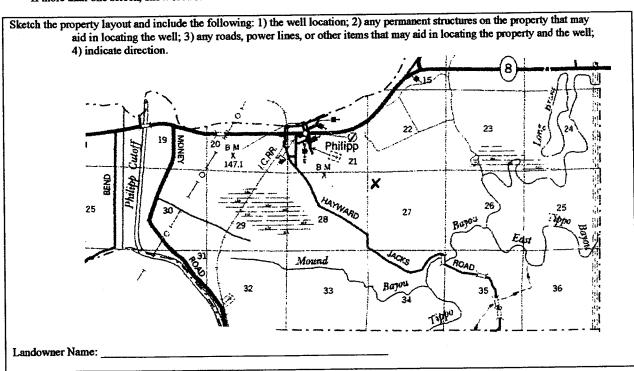

Signature of Water Well Contractor

STATE WELL REPORT

Part 2

For Office Use Only:		
Aquifer:		
Well #: <u>5-172</u> Elevation:	- -	

This report should be prepared by the pump installer in detail and filed with the Department within 30 days of the installation of pump.

installation of pump.		
Well Owner Information	Well Location	
Owner Name: Gregory Properties, LLC	Latitude: Longitude:	
Mailing Address: 1505 Gale Lane	Method of Lat/Long (circle one): Conventional Survey,	
	USGS quad, Hand-held GPS, Survey-grade GPS	
Nashville, TN 37212	NW 14 NW 14 Sec 27 Twn 22N Rng 1E	
City State Zip Code		
	Distance Direction Nearest Town	
Telephone No. (662-647-2623 Contact Person: Gerry Speir	1 Miles SE of Philipp	
Pump Type Circle one	Power Type	

	Pump Type Circle one			Power Type Circle one	
Air Lift	Jet	Submersible	Diesel Engine	Gasoline Engine	Natural Gas
Bucket	Piston	Turbine	Electric Motor	Hand	Tractor PTO
Centrifugal	Rotary	Flowing Well	Windmill	Other (specify):	
Other (specify):			Horse Power Ratin	g of Motor: 60	
Date Pump Installed:	7-20	0-05	Setting Depth:	70	feet
Rated Pump Capacity:	2500	_Gallons Per Minute	Number of Stages:	2	

Pump Test Data	Method of Measuring Water Level Circle one		
Date Well Tested:	Circle one		
Static Water Level (A):Feet Below Land Surface	Air Line Electric Measuring Line Steel Tape		
Pumping Water Level (B):Feet Below Land Surface	Other (specify):		
Drawdown [(B) - (A)]:Feet Below Land Surface	For flowing well, measured shut in head:feet		
Test Pumping Rate:Gallons Per Minute	Well yieldedGPM with a drawdown of		
Duration of Pump Test (minimum 4 hours):hours	feet afterhours of pumping		

I HEREBY CERTIFY that the above statements are true to the best of	my knowledge,	,		٢	
Patrick M. Chism 0695	Patrick	M	Chur		
Print Name of Pump Installer and License No. (if applicable)			mp Installer		

RECEIVED

AUG 0 1 2005

BY: OLWR

County:	Tallaha	atchie_
Permit#: Irri Driller:	gation 1	Equipment
Date drill	ing completed:	7-20-05

State Well Report

Part 1

Mississippi Department of Environmental Quality
Office of Land and Water Resources
P.O. Box 10631
Jackson, MS 39289-0631
(601)961-5210
(601)354-6938 (fax)

For Office Use Only:	
Aquifer:	
Well #: 5-172	
L. S. Elevation:	
E-log #:	_

State Law requires that this report be prepared by the driller in detail and filed with the Department within

30 days of completion of drilling of the well.				
Well Owner Information	Well Location			
Owner Name Gregory Properties, LLC	Latitude: "Longitude: ""			
Mailing Address: 1505 Gale Lane	Method of Lat/Long (circle one): Conventional Survey,			
	USGS quad, Hand-held GPS, Survey-grade GPS			
	NW _{1/4} NW _{1/4} Sec 27 Twn 22N Rng 1E			
Nashville, TN 37212	74 74 Sec 1 wii King			
City State Zip Code	Distance Direction Nearest Town			
Telephone No. (662-647-2623	1 Miles SE OBHITALIA			
Contact Person: Gerry Speir				
Well 1)ata			
Purpose of Well (circle one) Home Industrial Public Supply	1,100			
Date well drilling started: 7-20-05 Date w	vell drilling completed: 7-20-05 YMD JOINT WATER			
If flowing, method of flow regulation: Valve Other (d	escribe) NANAGEMENT DISTRICT			
Static Water Level: 14' feet above or below (circle one) I	and surface Date measured: 7-20-05			
Method of Measurement (circle one) teel tape electric tape	air line other:			
Hole depth: 117' Well depth: 117'	Well grouted to a depth offeet			
Type of grout (circle one): Cement Bentonite Mix				
Casing length: 77 feet Casing diameter: 16	inches Type of casing: PVC Sch. 40			
Screen length: 40 feet Screen diameter: 16	inches Type of screen: PVC Sch. 40			
Screen slot size:050 inches Setting depth: From _	78feet to117feet			
Type of completion (circle all applicable): Gravel packed Under	reamed Telescoped Open hole Natural Development			
Other (describe):				
Top of lap pipe or reduction in casing:feet. If telescoped or more than one screen, describe on back of page				
Logs run (circle all applicable): No log run Electric Gamma Ray Density Sonic Neutron Other:				
Name of organization running log(s):				
I certify that the well was drilled, constructed, and completed in accordance with all applicable requirements of the Mississippi				
Department of Environmental Quality and/or the Mississippi Department of Health regulations and state laws,				
Irrigation Equipment Inc.	b) + y m all 1			
Patrick M. Chism 0695 famile 11 (hbm.				
Print Name of Water Well Contractor and License No.	Signature of Water Well Contractor			