

**STATE OF MISSISSIPPI**

**Department of Environmental Quality**

**Office of Land and Water Resources**

**P.O.Box 2309**

**Jackson, Mississippi 39225**

**PERMIT**

**TO DIVERT OR WITHDRAW FOR BENEFICIAL USE THE PUBLIC WATERS**

This permit is issued to the landowner named below in accordance with the provisions of the Mississippi Water Laws, Mississippi Code Sections 51-3-1, et seq.(1972, as amended), and the regulations and standards as promulgated thereunder. Whether or not specifically named in this permit or in the applications for this permit, anyone using water from the diversion/withdrawal point described below shall do so in compliance with the provisions of this permit. Neither this permit, nor any authority conferred hereby, may be sold, conveyed, encumbered, assigned or otherwise aliened, for any period of time or under any conditions whatsoever. This permit may not be modified, transferred, or revoked without prior action by the Permit Board. Any attempts to modify, transfer or revoke this permit, or to take any other action on this permit, shall be invalid and unenforceable and may result in immediate revocation or suspension of this permit. The holder of this permit shall at all times be responsible for adherence to the terms and conditions of this permit. No agreement between the permit holder and any other party shall affect the obligations and liabilities of the permit holder. Water use under this permit is allowed only when the streamflow or lake level elevation (whichever, if any, is applicable) is above the established minimum, pursuant to Mississippi Code Section 51-3-7. Authorization is hereby granted to divert/withdraw water for the beneficial use designated herein, and for no other purpose, subject to the following terms, conditions, and limitations:

**Permit Number:** MS-GW-50678 **Total Permitted Acreage:** 122

**Landowner Name:** LINEBERRY, JASON  
**Landowner Address:** PO BOX 426  
FINLEY, TN 38030

**Source of Water:** MISSISSIPPI RIVER VALLEY ALLUVIAL AQUIFER

**Beneficial Use(s):** IRRIGATION

**Diversion/Withdrawal Location:** NE 1/4 of the NW 1/4 **Section:** 32 **Township:** 22N **Range:** 01E

**County:** TALLAHATCHIE **Quad:** MONEY

**Permitted Acreage:** **Irrigation:** 122 **Fish Culture:** 0 **Wildlife Management:** 0

**Maximum Volume:** See Special Terms And Conditions (attachment I)

**Applicant Name:** LINEBERRY, JASON  
**Applicant Address:** PO BOX 426  
FINLEY, TN 38030

**Date Permit Issued:** 07/22/2019

**Date Permit Expires:** 07/22/2024

**Date Permit Modified:**

**Date Permit Reissued:**

RECEIVED  
JAN 28 2020  
BY C

This permit shall be deemed null and void if construction has not begun within one (1) year of the permit issue date.

SPECIAL TERMS AND CONDITIONS 1:

See Attachment I which is hereby declared part of this permit.

RECEIVED  
JAN 28 2020  
LWR

  
Gary C. Rikard, Executive Director

County: Tallahatchie  
 Permit #: MS GW 50678  
 Driller: TEDDY Coats  
 Date drilling completed: 12-14-19

**State Well Report**  
**Part I - Driller's Log**

Mississippi Department of Environmental Quality  
 Office of Land and Water Resources  
 P.O. Box 2309  
 Jackson, MS 39225  
 (601)961-5210  
 (601)961-5228 (fax)

**For Office Use Only:**  
 Aquifer: S 198  
 Well #: \_\_\_\_\_  
 L. S. Elevation: \_\_\_\_\_  
 E-log #: \_\_\_\_\_

*State Law requires that this report be prepared by the license holder responsible for the work and filed with the Department at the above address within 30 days of completion of drilling of the well or borehole.*

Information on Well Owner (Landowner if borehole is not for a water well)	Well or Borehole Location
Owner Name: <u>Jason Hineberry</u>	Latitude: <u>33° 44' 25"</u> Longitude: <u>90° 12' 45"</u>
Mailing Address: <u>PO. Box 426</u>	Method of Lat/Long (circle one): <u>Hand-held GPS</u> Conventional Survey, <u>5495</u>
<u>Finley</u> <u>TN</u> <u>38030</u>	USGS quad, <u>NE 1/4 NW 1/4 Sec 32 Twn 22N Rng 01E</u>
City State Zip Code	Distance Direction Nearest Town
Telephone No. ( ) _____	<u>1</u> Miles <u>S</u> of <u>Phillip</u>

**Well / Borehole Data**

Date drilling started: 12-14-2019 Date drilling completed: 12-14-2019 Hole depth: 115 Hole diameter: 26

Location of the source of any surface water used for drilling: Nearest Well

Method of dosing and volume of Chlorine used in drilling and development: \_\_\_\_\_

Logs run (circle all applicable): No log run Electric Gamma Ray Density Sonic Neutron Other: \_\_\_\_\_

Name of organization running log(s): \_\_\_\_\_

Purpose of borehole (check one): Water Well  Geotechnical/Geological Investigation \_\_\_\_\_ Ground Source Heat Pump \_\_\_\_\_

Seismic Survey \_\_\_\_\_ Other (describe) \_\_\_\_\_

*If drilling is not related to water well construction, skip the remainder of this block*

Purpose of Well (check one): Home \_\_\_\_\_ Industrial \_\_\_\_\_ Public Supply \_\_\_\_\_ Irrigation  Fish Culture \_\_\_\_\_ Other: \_\_\_\_\_

If a flowing well, method of flow regulation: Valve \_\_\_\_\_ Other (describe) \_\_\_\_\_

Static Water Level: 20 feet above or below (circle one) land surface Date measured: 12-14-2019

Method of Measurement (circle one) steel tape  electric tape \_\_\_\_\_ air line \_\_\_\_\_ other: \_\_\_\_\_

Well depth: 115 Well grouted to a depth of 10 feet Type of grout (circle one): Neat Cement  Bentonite \_\_\_\_\_ Mix \_\_\_\_\_

Casing length: 75 feet Casing diameter: 16 inches Type of casing: P.V.C.

Screen length: 40 feet Screen diameter: 16 inches Type of screen: P.V.C.

Screen slot size: 050 inches Setting depth: From 0 feet to 60 feet

Type of completion (circle all applicable): Gravel packed \_\_\_\_\_ Underreamed \_\_\_\_\_ Telescoped \_\_\_\_\_ Open hole \_\_\_\_\_ Natural Development \_\_\_\_\_

Other (describe): \_\_\_\_\_


Top of lap pipe or reduction in casing: \_\_\_\_\_ feet. *If telescoped or more than one screen, describe on next page*

**RECEIVED**  
**JAN 28 2020**  
**BY OLWR**

The sketch below only required for water wells

If well telescopes, show depths on sketch

Ground Level →

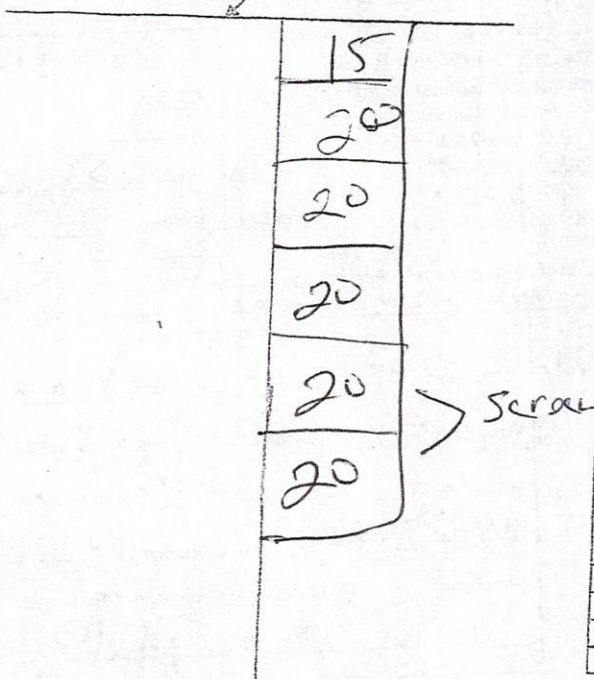


Description of formations encountered must be provided for all wells and boreholes, unless specifically exempted by regulations

Description of Formations Encountered	From (depth)	To (depth)
Dirt	Ground Level	10
Dirt	10	20
Hard Sand	20	40
Course Sand	40	60
Course Sand	60	80
Small Gravel	80	100
Gravel	100	115

If more than one screen, show location of each on sketch

Sketch the property layout and include the following: 1) the well location; 2) any permanent structures on the property that may aid in locating the well; 3) any roads, power lines, or other items that may aid in locating the property and the well; 4) a north arrow

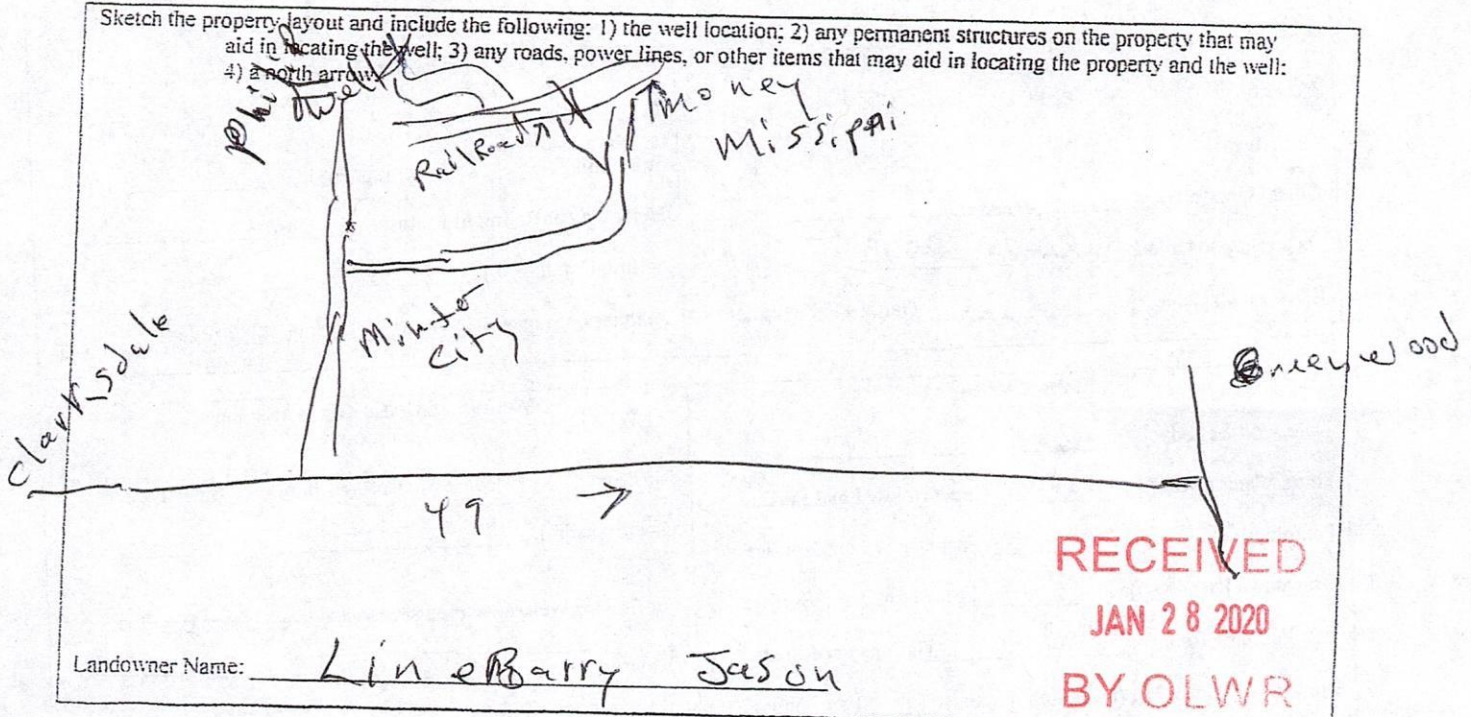

RECEIVED  
 JAN 28 2020  
 BY OLWR

Landowner Name: Lin e Barry Jason

Form: OI.WR-SWR-1A (04/08)

I certify that the well/borehole was drilled, constructed, and completed in accordance with all applicable requirements of the Mississippi Department of Environmental Quality and the Mississippi Department of Health regulations, if applicable, and state laws.

TEDDY Coats #5318

12-14-2019

*Teddy Coats*

Print Name of Responsible Licensee and License No.

Date

Signature of Licensee

# STATE WELL REPORT

## Part 2

**Pump Installer's Completion Report**  
 Mississippi Department of Environmental Quality  
 Office of Land and Water Resources  
 P.O. Box 2309  
 Jackson, MS 39225  
 (601)961-5210  
 (601)961-5228 (fax)

County: Tallahatchie  
 Permit #: MS. LW. 50678  
 Driller: TEDDY LOUIS  
 Date completed: 12-14-2019  
*Copy information from block on Part 1*

**For Office Use Only:**

Aquifer: \_\_\_\_\_  
 Well #: 5198  
 Elevation: \_\_\_\_\_

*This part of the report must be completed by a licensed water well contractor or a licensed pump installer. A copy of Part 1 of the report must be attached and both parts filed with the Department at the above address within 30 days of well completion.*

Well Owner Information	Well Location
Owner Name: <u>Justin Lineberry</u>	Latitude: <u>33-44-25</u> Longitude: <u>90-12-45</u>
Mailing Address: _____	Method of Lat/Long (check one): Conventional Survey _____ <span style="margin-left: 100px;">Hand-held GPS <input checked="" type="checkbox"/> Survey-grade GPS _____</span>
<u>Po Box 426</u>	USGS quad _____, Hand-held GPS <input checked="" type="checkbox"/> Survey-grade GPS _____
<u>Finley MS 38030</u>	<u>NE 1/4 NW 1/4 Sec 32 T22N R 01E</u>
City _____ State _____ Zip Code _____	Distance _____ Direction _____ Nearest Town _____
Telephone No. ( ) _____	<u>1</u> Miles <u>S</u> of <u>Phillip</u>

Pump Type Circle one	Power Type Circle one
Air Lift <input type="checkbox"/> Jet <input type="checkbox"/> Submersible <input type="checkbox"/>	<input checked="" type="checkbox"/> Diesel Engine <input type="checkbox"/> Gasoline Engine <input type="checkbox"/> Natural Gas
Bucket <input type="checkbox"/> Piston <input type="checkbox"/> <input checked="" type="checkbox"/> Turbine	Electric Motor <input type="checkbox"/> Hand <input type="checkbox"/> Tractor PTO
Centrifugal <input type="checkbox"/> Rotary <input type="checkbox"/> Flowing Well <input type="checkbox"/>	Windmill <input type="checkbox"/> Other (specify): _____
Other (specify): _____	Horse Power Rating of Motor: <u>60</u>
Date Pump Installed: <u>12-14-2019</u>	Setting Depth: <u>6-60</u> feet
Rated Pump Capacity: <u>2500</u> Gallons Per Minute	Number of Stages: <u>2-Stage 12</u>

Pump Test Data	Method of Measuring Water Level Circle one
Date Well Tested: <u>12-14-2019</u>	Air Line <input type="checkbox"/> <input checked="" type="checkbox"/> Electric Measuring Line <input type="checkbox"/> Steel Tape
Static Water Level (A): <u>20</u> Feet Below Land Surface	Other (specify): _____
Pumping Water Level (B): <u>30</u> Feet Below Land Surface	For flowing well, measured shut in head: _____ feet
Drawdown [(B) - (A)]: <u>10</u> Feet Below Land Surface	Well yielded <u>2000</u> GPM with a drawdown of _____
Test Pumping Rate: <u>2000</u> Gallons Per Minute	<u>10</u> feet after <u>4</u> hours of pumping
Duration of Pump Test (minimum 4 hours): <u>4</u> hours	<b>RECEIVED</b>

I HEREBY CERTIFY that the above statements are true to the best of my knowledge.

TEDDY LOUIS #5318 Jeddy LOUIS R  
 Print Name of Pump Installer and License No. (if applicable) Signature of Pump Installer

JAN 28 2020

Form: OLWR-SWR-1B (04/08)