

TALLAHATCHIE

S 2000

5-8-76

MISSISSIPPI BOARD OF WATER COMMISSIONERS

416 North State Street
15F Jackson, Mississippi 39201

WATER WELL DRILLERS LOG

5-8
date well completed

76 Lime Well Co. Tallahatchie
firm name county well located

LANDOWNER:

D. C. Parish

Philipp Miss.
(mailing address)

description of formations encountered

from to

Top soil	0	20
Sand	20	40
"	40	160
Clay	160	200
Clay and rocks	200	300
Sand and Clay	300	320
Sand	320	340
Clay	340	380
Sand	380	400
"	400	420
Clay	420	460
Sand and Clay	460	480
" " "	480	500
Sand	500	520
"	520	560
Sand and Clay	560	580
Clay	580	600
"	600	620
"	620	660
"	660	700
Good Sand	700	790

WELL LOCATION:

sec. 19 T 22 N R 1 E
1 1/2 miles west of Philipp
(distance) (direction) (nearest town)

WELL PURPOSE:

(home, irrigation, municipal, industrial)

WELL COMPLETION DATA:


- (1) diameter (inches) 2"
- (2) total depth (feet) 790
- (3) static water level (feet) flowing below top of ground.
- (4) casing 9 gal. 770.
(material) (depth)
2 (size) If telescope see back.
- (5) screen 20 770
(length) (depth to top)
2 (size) S.S. (material)
- (6) pump 1/3 8
(HP) (yield gpm)
elec. (type power)
- (7) electric log non
(yes or no)
non
(organization running log)
- (8) how well bottom plugged 90% plug

DRILLERS REMARKS:

WIN - 1 1976

If well telescopes please sketch and show depths.

GROUND LEVEL

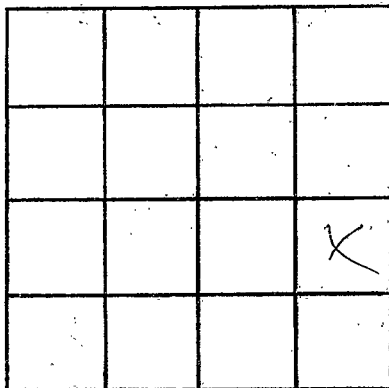

SECTION 19

Please indicate well location X.

ADDITIONAL INFORMATION

If more than one screen, show locations of each on sketch.