

TALLAHATCHIE

S 2003

3/23/77

MISSISSIPPI BOARD OF WATER COMMISSIONERS
416 North State Street
Jackson, Mississippi 39201

WATER WELL DRILLERS LOG

3/23/77
date well completed

150 BUTANE GAS CO. OF GREENWOOD
firm name

Tallahatchie
county well located


LANDOWNER:	description of formations encountered	from	to
J.W. Fenwell			
Philipp (mailing address)	Clay SAND & CLAY	0 40 40 94	
WELL LOCATION:			
sec. <u>34</u> T <u>22</u> N R <u>1</u> E S 8 VP			
<u>2</u> miles <u>SE</u> of <u>Philipp</u> (distance) (direction) (nearest town)			
WELL PURPOSE: <u>AG</u> (home, irrigation, municipal, industrial)			
WELL COMPLETION DATA:			
(1) diameter (inches) <u>4"</u>			
(2) total depth (feet) <u>84</u>			
(3) static water level (feet) <u>7</u> below top of ground. above			
(4) casing <u>PVC</u> , <u>54</u> (material) (depth)			
<u>4"</u> (size) if telescope see back.			
(5) screen <u>30'</u> , <u>54</u> (length) (depth to top)			
<u>4"</u> , <u>PVC</u> (size) (material)			
(6) pump <u>2</u> , <u>70</u> (HP) (yield gpm)			
<u>Elec.</u> (type power)			
(7) electric log <u>N/O</u> (yes or no)			
(organization running log)			
(8) how well bottom plugged <u>Back Pressure Valve</u>			
DRILLERS REMARKS:			

RECEIVED
MAR 25 1977

MISS. BD. OF WATER COMMISSIONERS

If well telescopes please sketch and show depths.

GROUND LEVEL

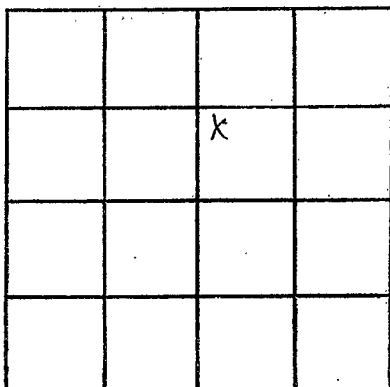

SECTION 34

Please indicate well location X.

ADDITIONAL INFORMATION

If more than one screen, show locations of each on sketch.