

TALLAHATCHIE

9 2004

2-15-80

MISSISSIPPI BOARD OF WATER COMMISSIONERS 416 North State Street Jackson, Mississippi 39201

WATER WELL DRILLERS LOG BUTANE GAS COMPANY

2-15-80 date well completed

OF GREENWOOD well name

Tallahatchie county well located

LANDOWNER: A.C. Bartlett Philip (mailing address)

Table with 4 columns: description of formations encountered, from, to. Rows include Clay, Sand, Sand & Gravel, Clay, Sand with depth markers.

WELL LOCATION: sec 10 T 22 N R 1 E 2 1/2 miles NE of Philip (distance) (direction) (nearest town)

WELL PURPOSE: Home (home, irrigation, municipal, industrial)

WELL COMPLETION DATA: (1) diameter (inches) 4" (2) total depth (feet) 136 (3) static water level (feet) 85 below top of ground. (4) casing PVC 126 (material) (depth) 4 (size) if telescope see back. (5) screen 10 126 (length) (depth to top) 4" PVC (size) (material) (6) pump 1/2 10 (HP) (yield gpm) Elec (type power) (7) electric log (yes or no) (organization running log)

(8) how well bottom plugged Back Pressure not able

DRILLERS REMARKS:


DEPT. OF NATURAL RESOURCES BUREAU OF LAND & WATER RESOURCES

FEB 25 1980

RECEIVED

If well telescopes please sketch and show depths.

GROUND LEVEL

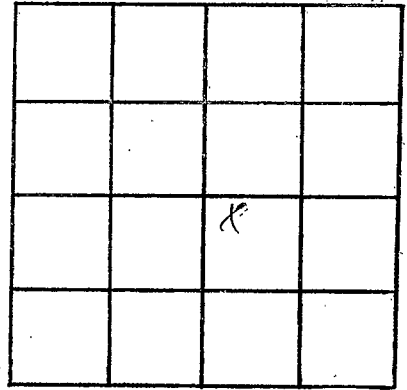

SECTION 15

Please indicate well location X.

ADDITIONAL INFORMATION

If more than one screen,
show locations of each on sketch.